




98

BAYVIEW BOULEVARD


← To Seaside OREGON COAST HWY. 101

To Tillamook

NEHALEM BAY

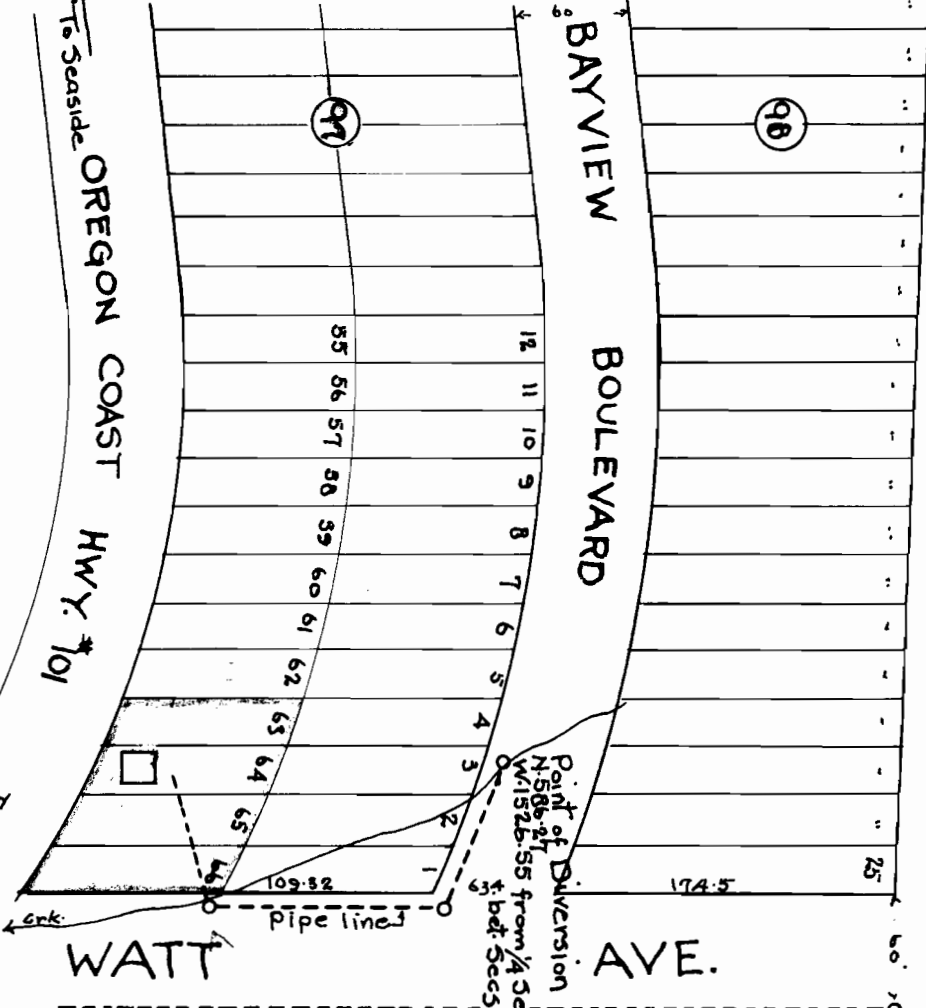

Initial Point of BRIGHTON BEACH
N 45° 27' W 132.35 from 1/4 Sec. Cor.
between Secs. 9 & 15, T2N. R10W. WM.

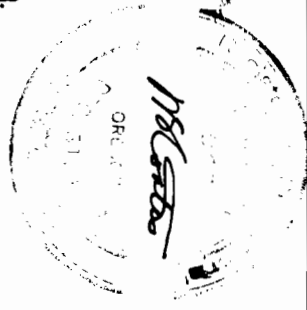

Lot 4, Sec 9 T2N. R10W. WM.

Application No. 23353

Permit No. 18401

J. E. GALYCE & NYLUND


APPLICATION FOR WATER RIGHT

Lots 63-64-65-66, Block 97

BRIGHTON BEACH
TILLAMOOK COUNTY, ORE.

SCALE 1"=100'

July-1948

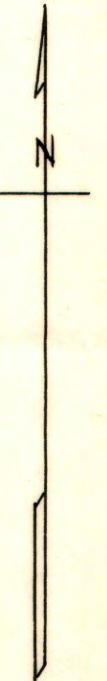


98

BAYVIEW BOULEVARD

← To Seaside OREGON COAST HWY. #101


To Tillamook

NEHALEM BAY

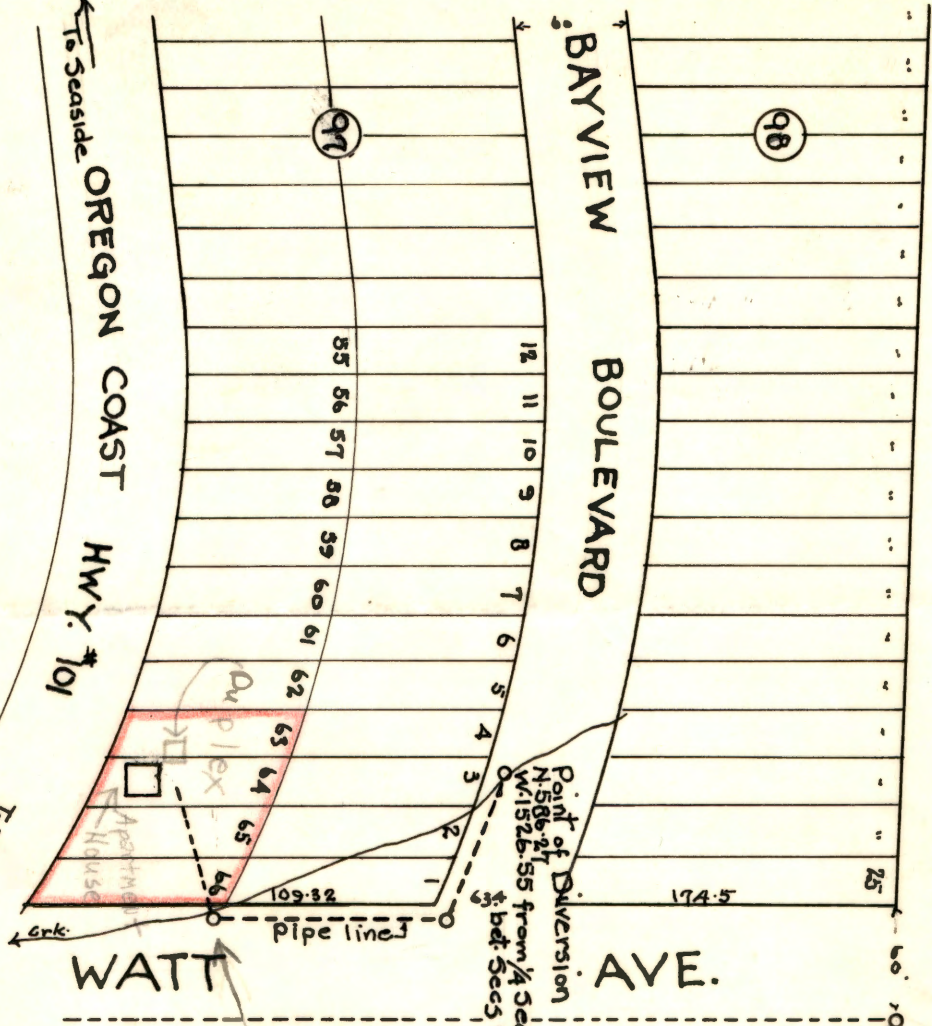

Initial Point of BRIGHTON BEACH
N. 45° 27' from 1/4 Sec. Cor.
W. 132° 35' between Secs. 9, 16, T2N. R10W. WM.

Supply Tank
Lot 4, Sec 9, T2N. R10W. WM.

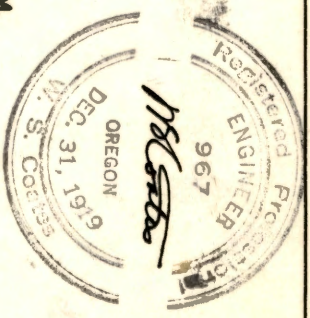

RECEIVED

STATE ENGINEER
SALEM, OREGON

Application No. 23353
Permit No. 18401

J. E. RALYCE & NYLUND

APPLICATION FOR WATER RIGHT

Lots 63-64-65-66, Block 97
BRIGHTON BEACH
TILLAMOOK COUNTY, ORE.
SCALE 1"=100'

July-1948

23353 1-124