


T25R9WWM

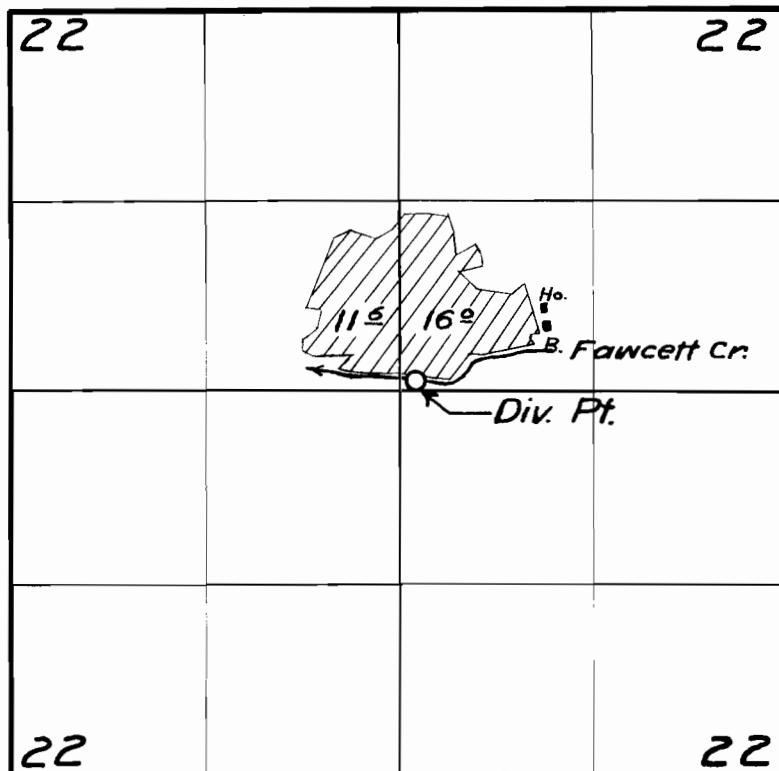

FINAL PROOF SURVEY

UNDER

Application No. 23409. Permit No. 18480.

IN NAME OF

JAMES NOTEBOOM

Surveyed Sept 7 1955, by *m. Bish*