


T.4S.R.9W.W.M.

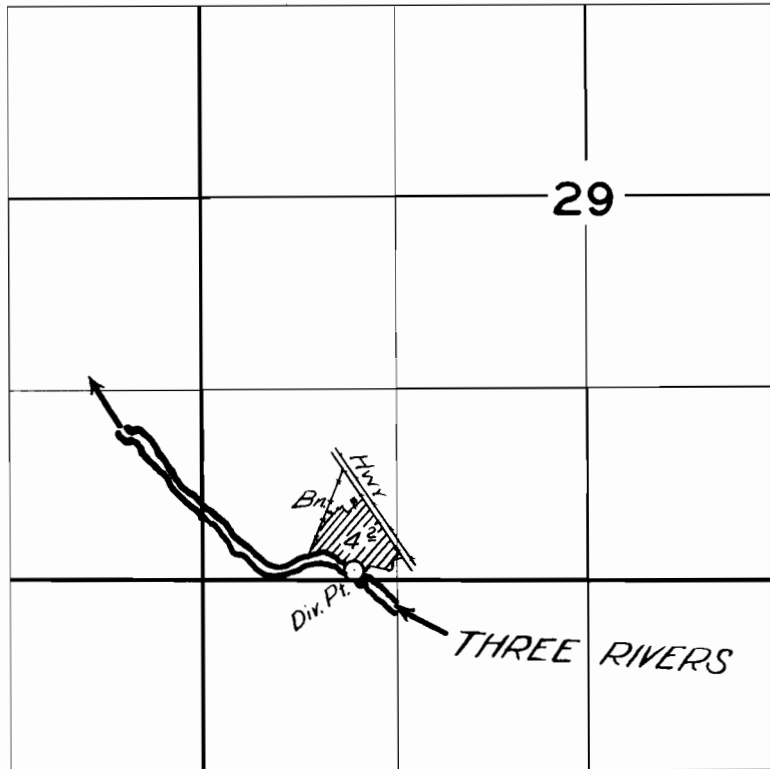

**FINAL PROOF SURVEY**

UNDER

Application No. 23418 Permit No. 18566

IN NAME OF

*MRS. F. J. SARGENT*

Surveyed 1 Sep. 1955, by *R. A. Whiteby*

1955-E