


24290
Ho. Spring
Ditch
Dam

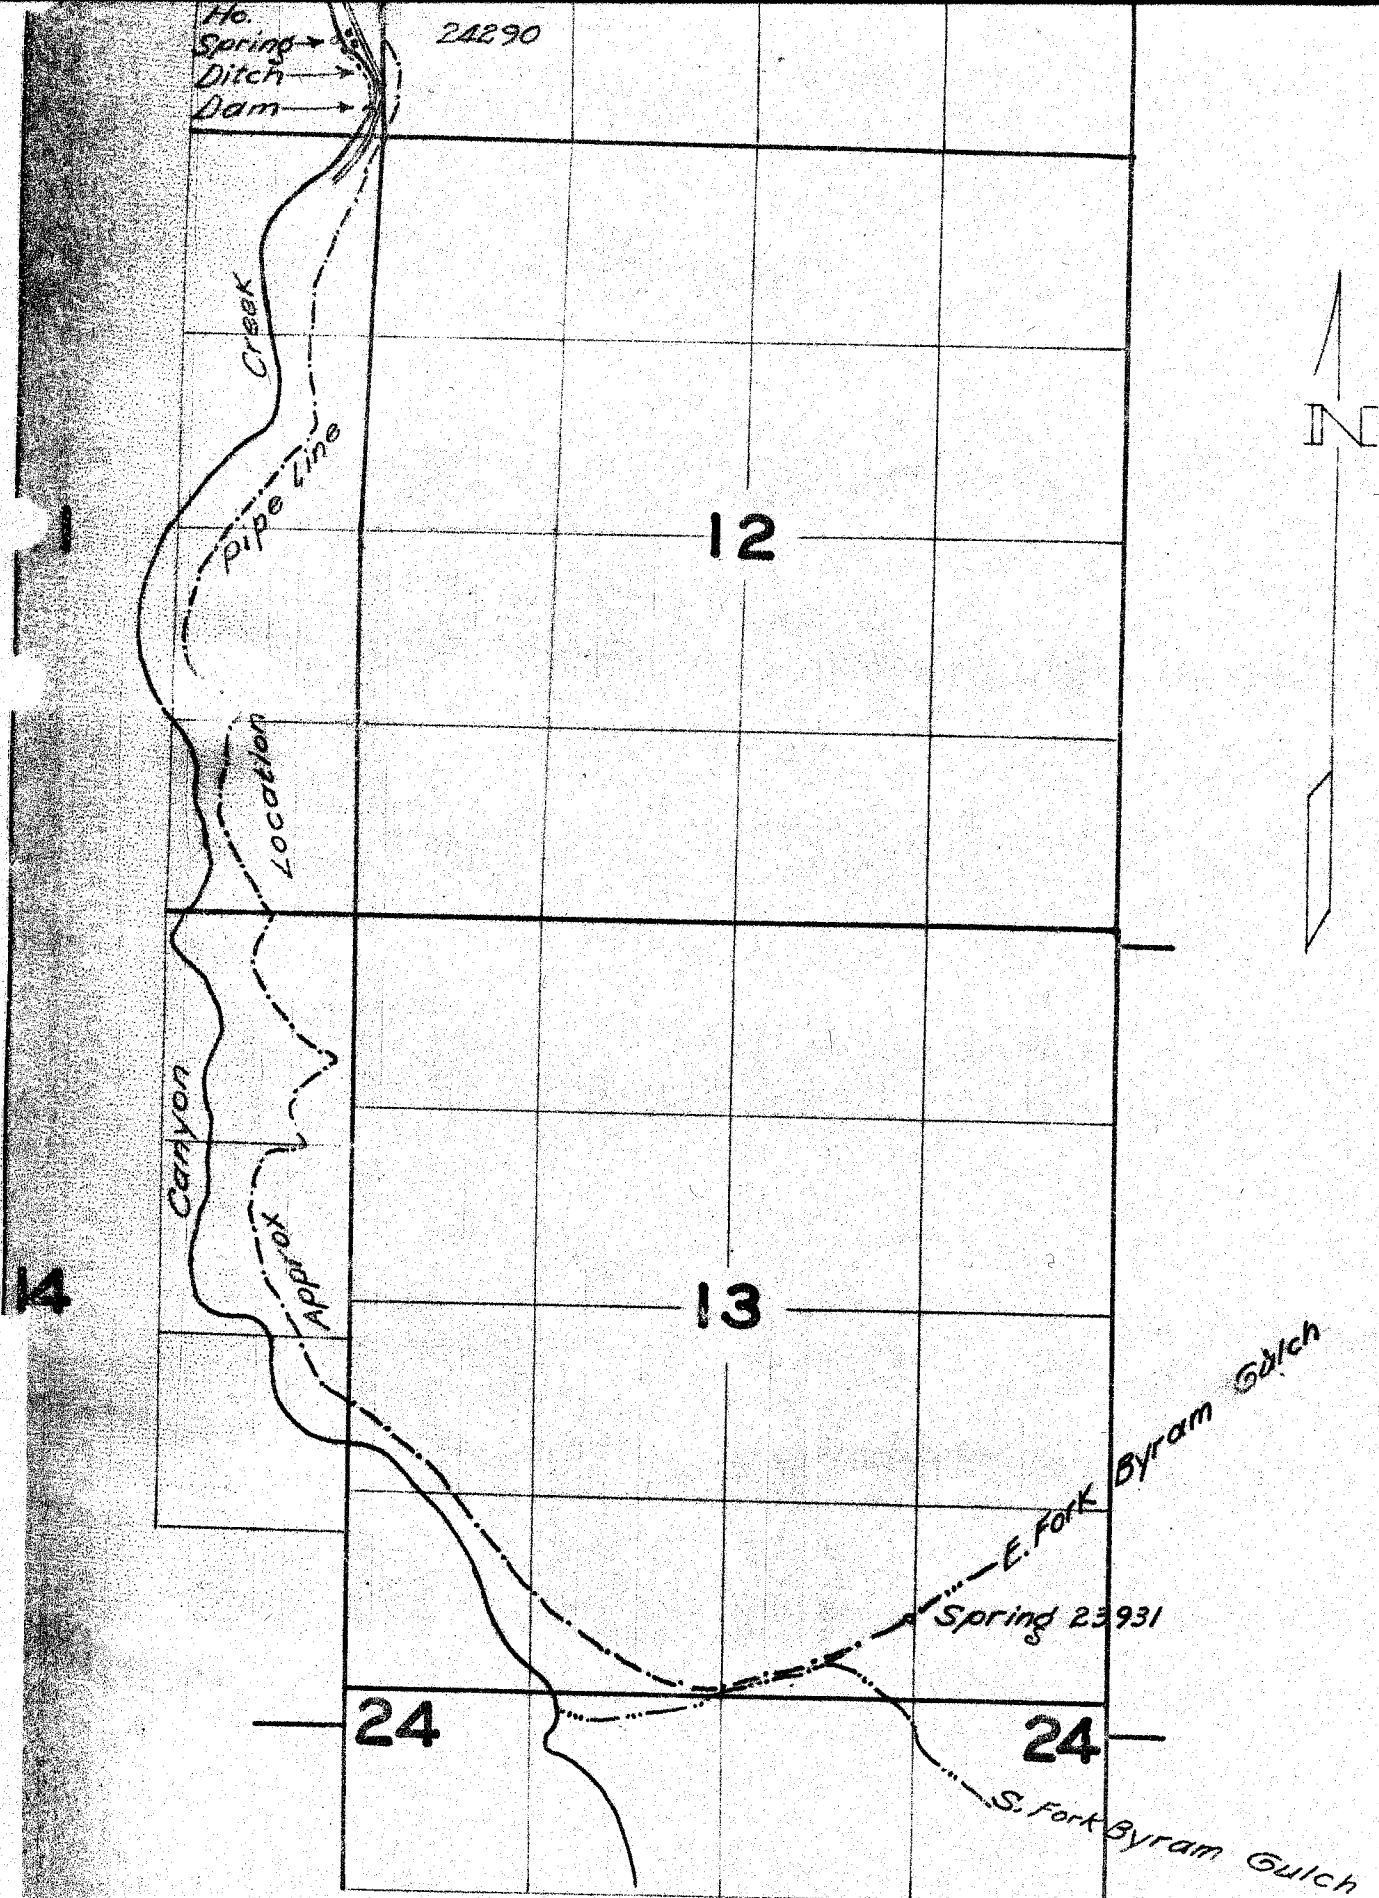

FINAL PROOF SURVEY
 Con M. Medina Appl. No. 24290 Permit No. 19120
 Roy Kilpatrick 27052 21516
 City of Canyon City 23931 18845



