


T. 25 S, R. 6 W.

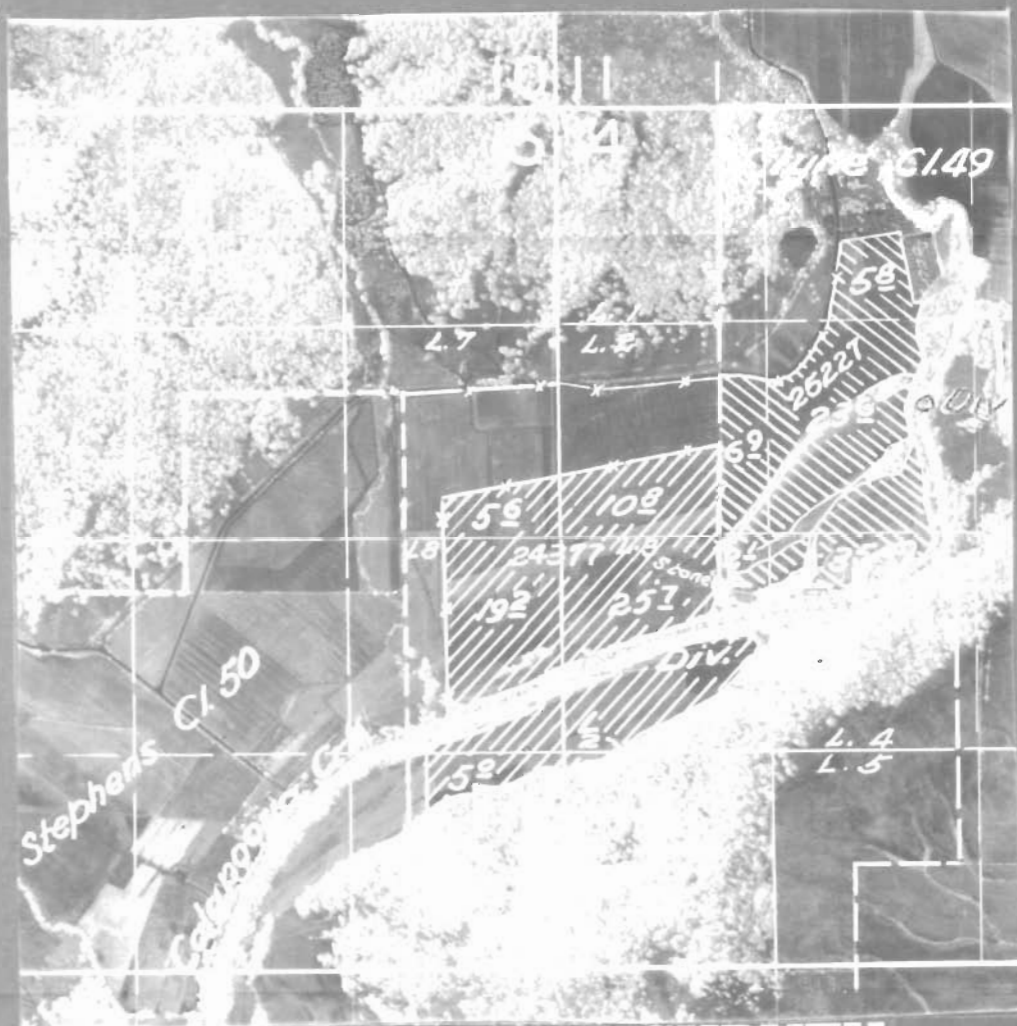

**FINAL PROOF SURVEY  
UNDER**

Name	Appl. No.	Permit No.
Geo. M. Wilcox and Son	24377	19114
Allen N. Esselstrom	25227	19824

Surveyed May 15, 1954 by H. L. Coffman

DB-HW-19-31