


T.6S.R.7W.WM

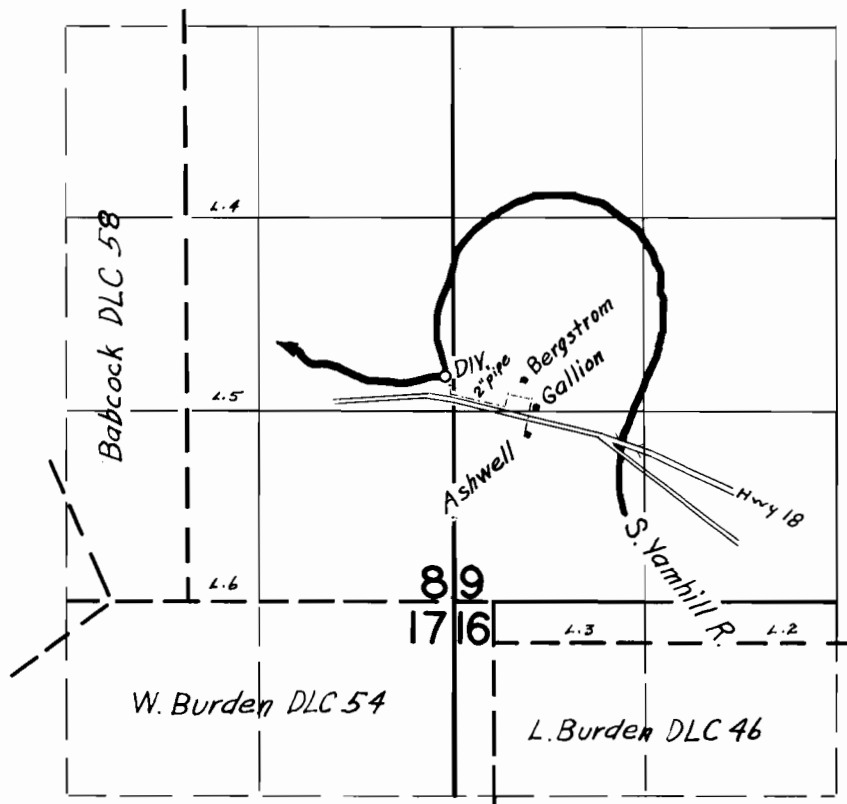

FINAL PROOF SURVEY

UNDER

Application No. 25794... Permit No. 20168....

IN NAME OF

Homer Gallion; Frank E. Bergstrom; Wesley Ashwell

Surveyed Aug. 20, 1954, by T. Jones.....