


Per 20479
21482

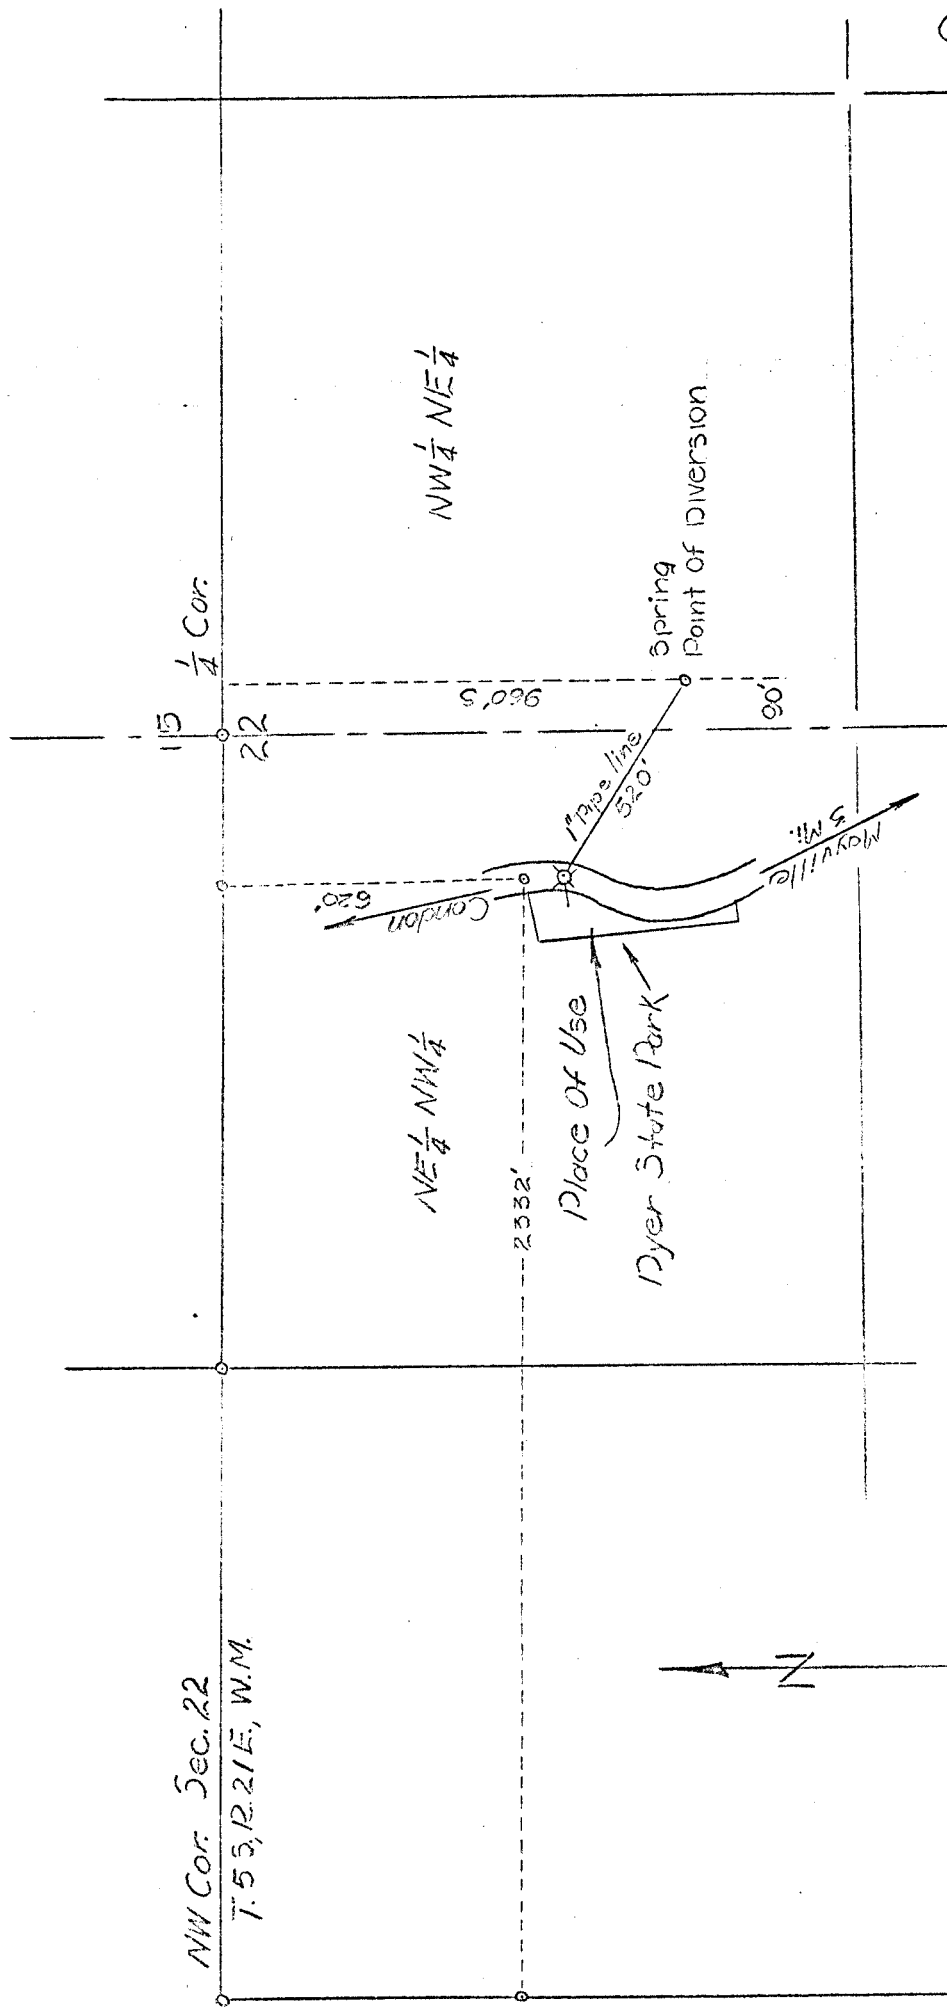

Dyer State Park Map

Application for Interception
 Dyer State Park
 In Sec. 22, T. 55, R. 21 E., W. M.
 Scale: 1" = 400'

Application No. 24622
 Permit No. 20479

24622
 C-22