


Application No 26310
Permit No 20651

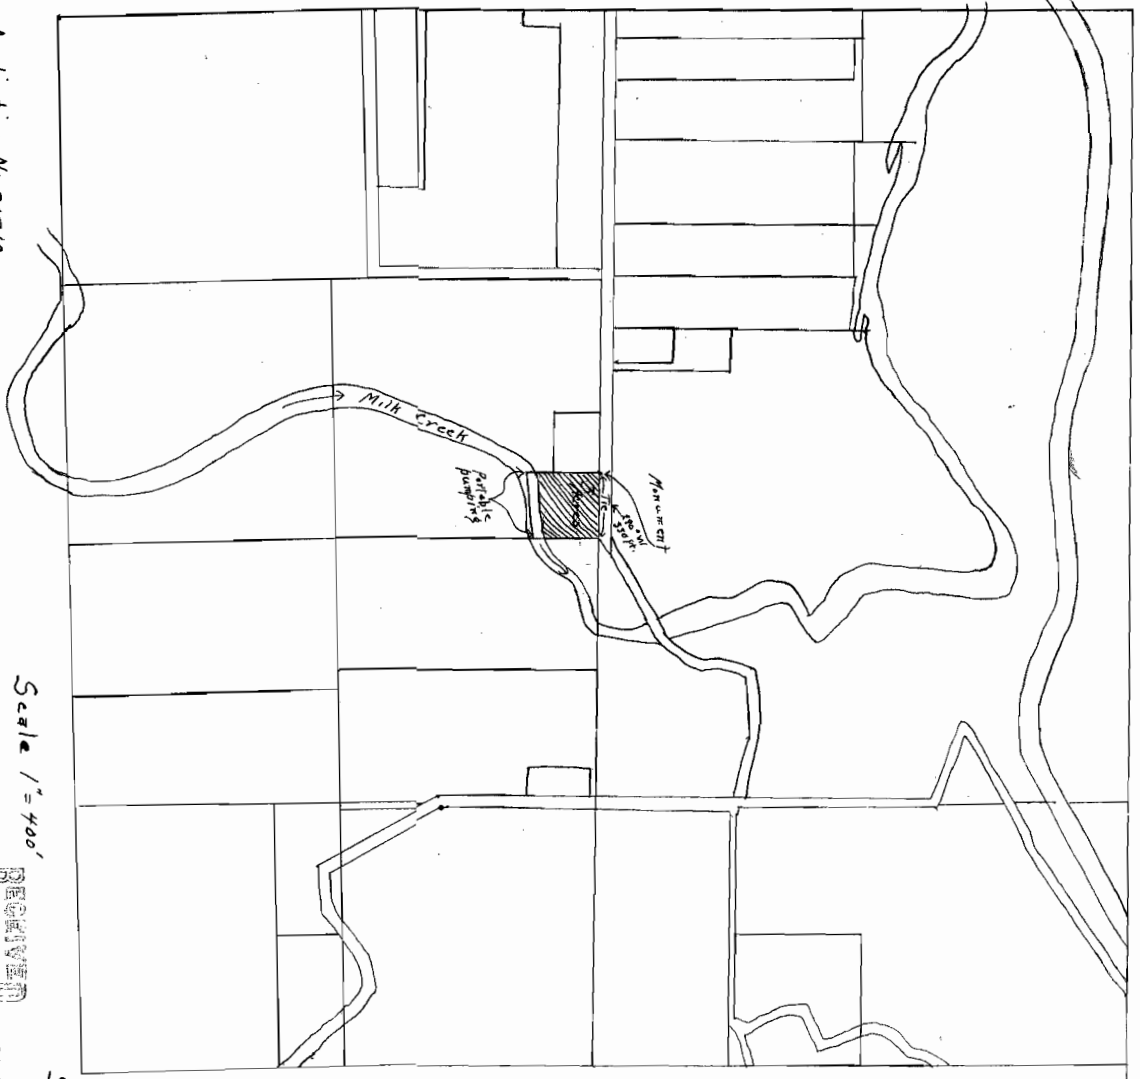

Scale 1" = 400'

RECEIVED
NOV 1 1981
STATE ENGINEER
SALER, OREGON

RECEIVED
SEP 10 1981
STATE ENGINEER
SALER, OREGON

Sec. 16
T4S R2E