T.14S.R.4W.WM

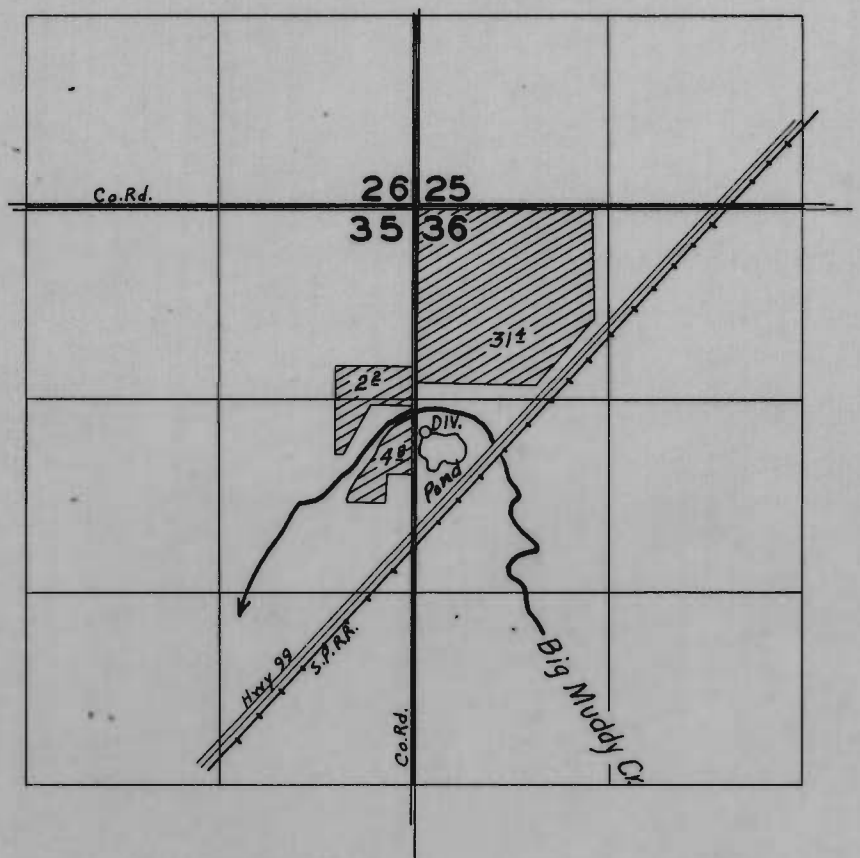

FINAL PROOF SURVEY

UNDER