


1
N

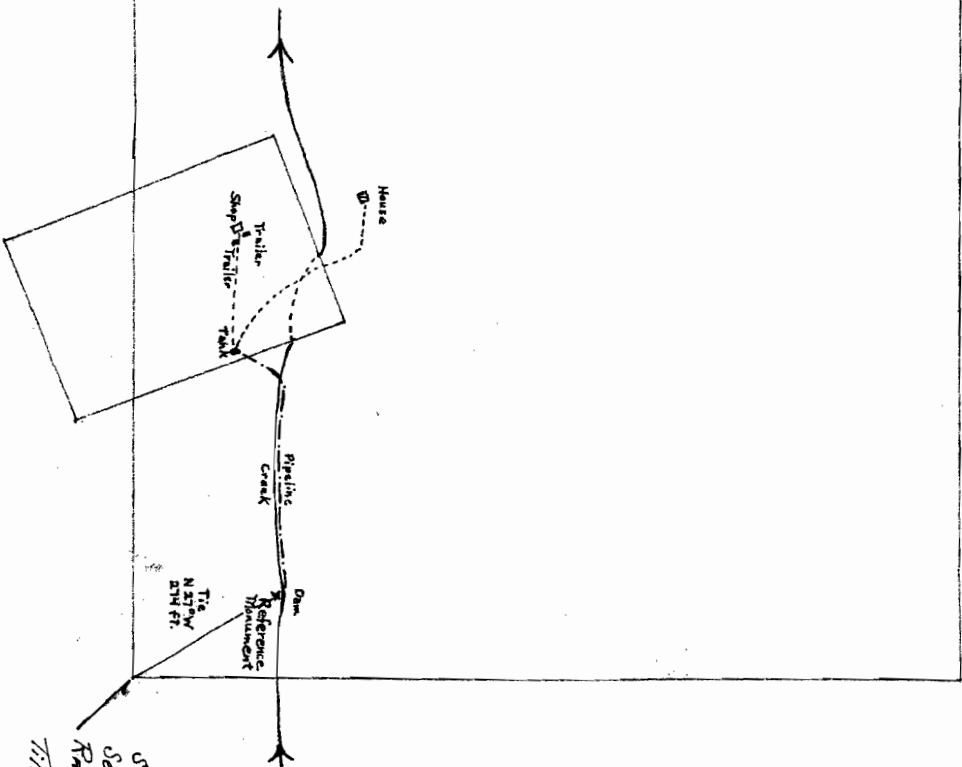

RECEIVED
JUL 3 1966

SE corner of SW 1/4, SE 1/4
Section 4, Township 5 South,
Range 10 West, 11th
Tillamook, Gentry.

Application No. 27686
Permit No. 21651