


Section 19

T. 40 S., R. 3 W., W.M.

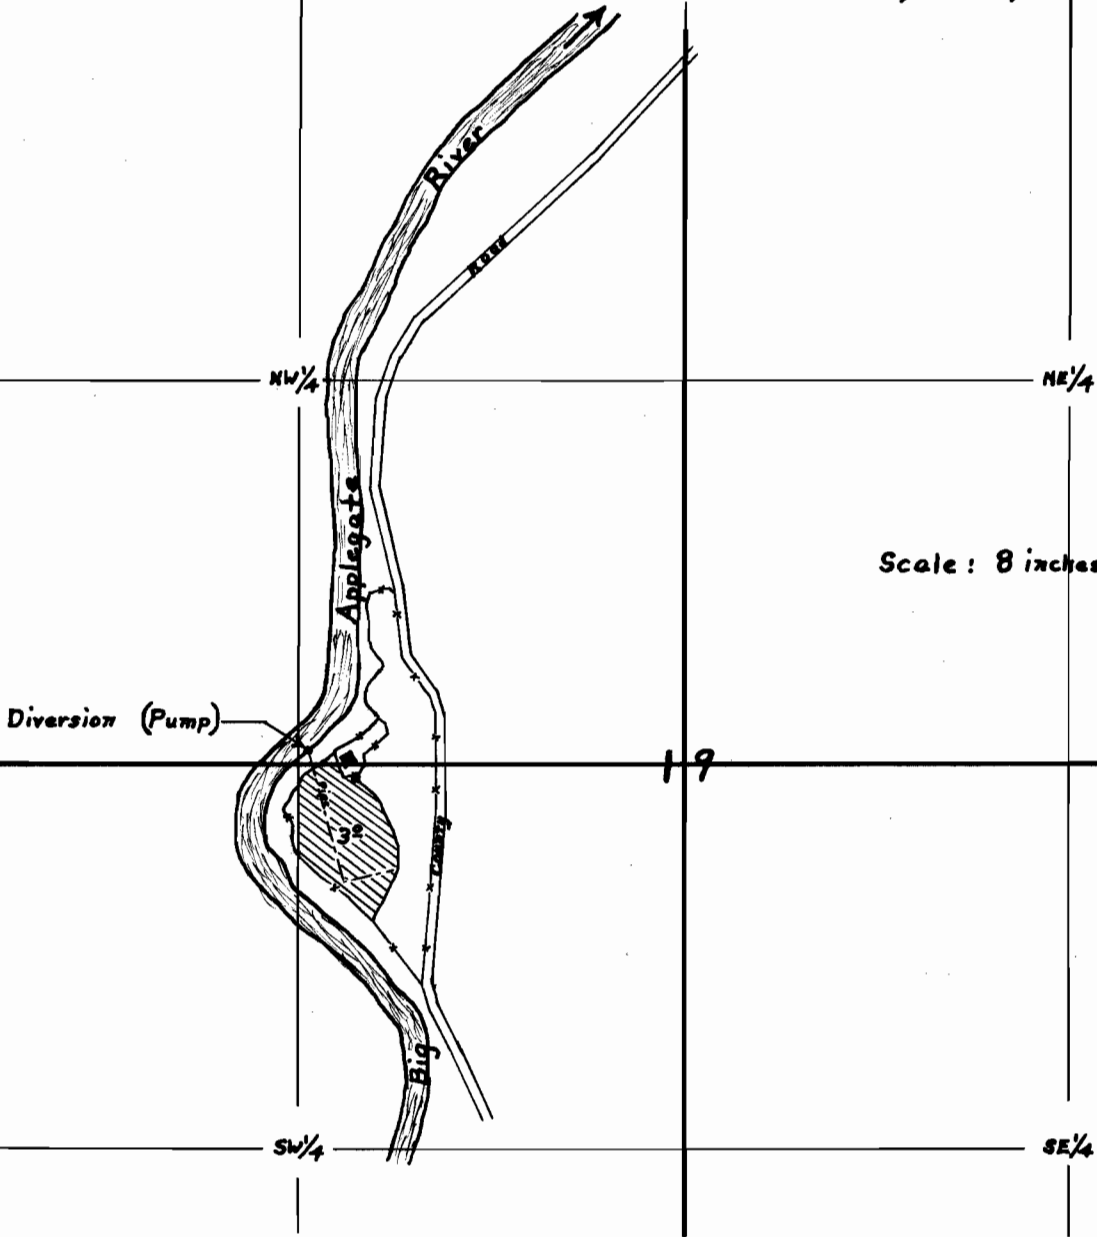

Scale: 8 inches = 1 mile

# FINAL PROOF SURVEY

UNDER

Application No. 27627... Permit No. 21761.....

IN NAME OF

Gerald Buck.....

Surveyed March 16, 1956., by D.C. Hendrix, W.M.

RECEIVED  
 MAR 28 1956  
 STATE ENGINEER  
 OREGON