Per < 21829
21828
21499
21500

T. 8 S. R. 30 E. W.M.

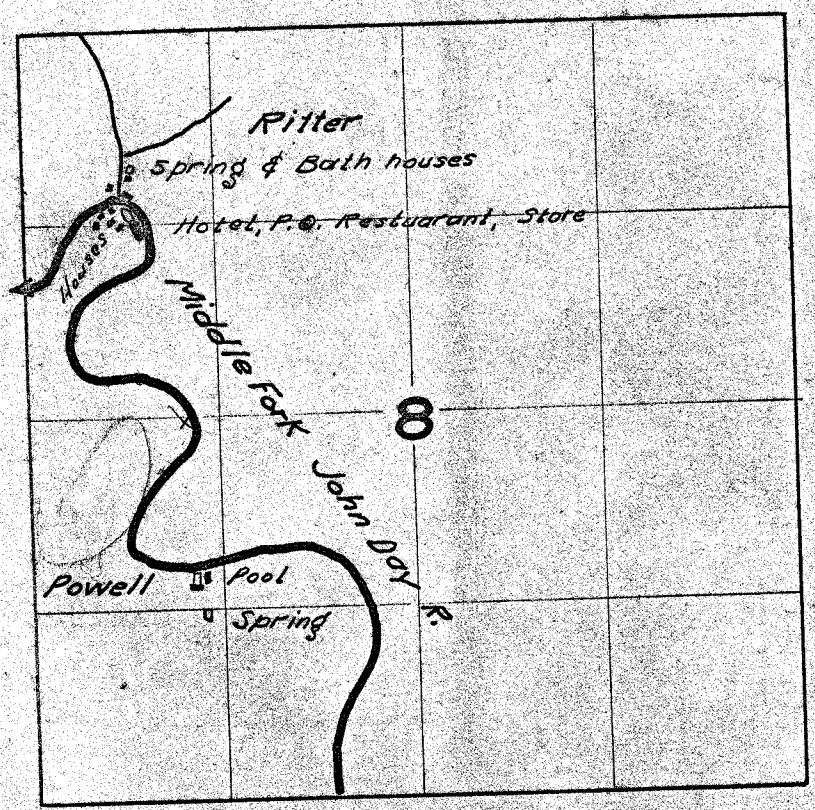

FINAL PROOF SURVEY

UNDER

Application No. 28053 (28052) Permit No. 21829 (21828)

IN NAME OF

Ritter Hot Springs

Surveyed Aug. 26 1954, by H. L. Coffman

BTU-24-34
Pantograph