



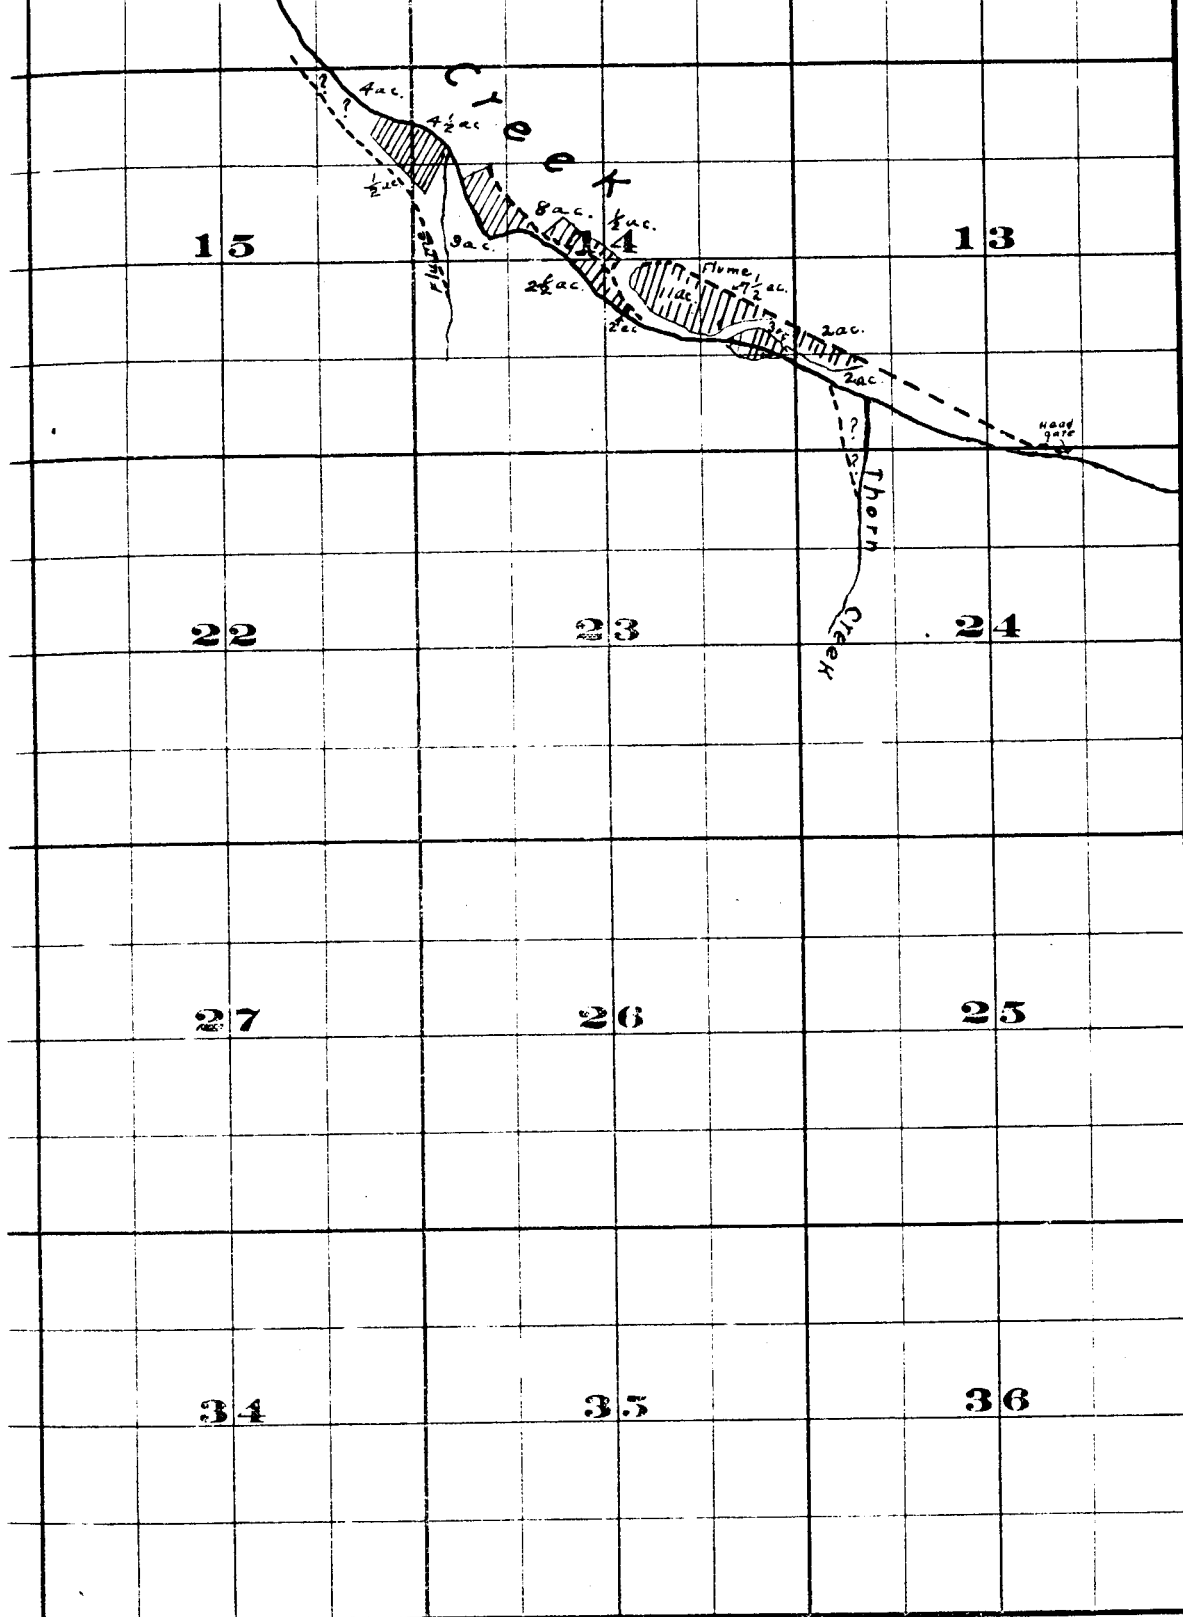

FROM OFFICE OF THE STATE ENGINEER, SALEM, OREGON

Willow Creek Adjudication

4 S. 26

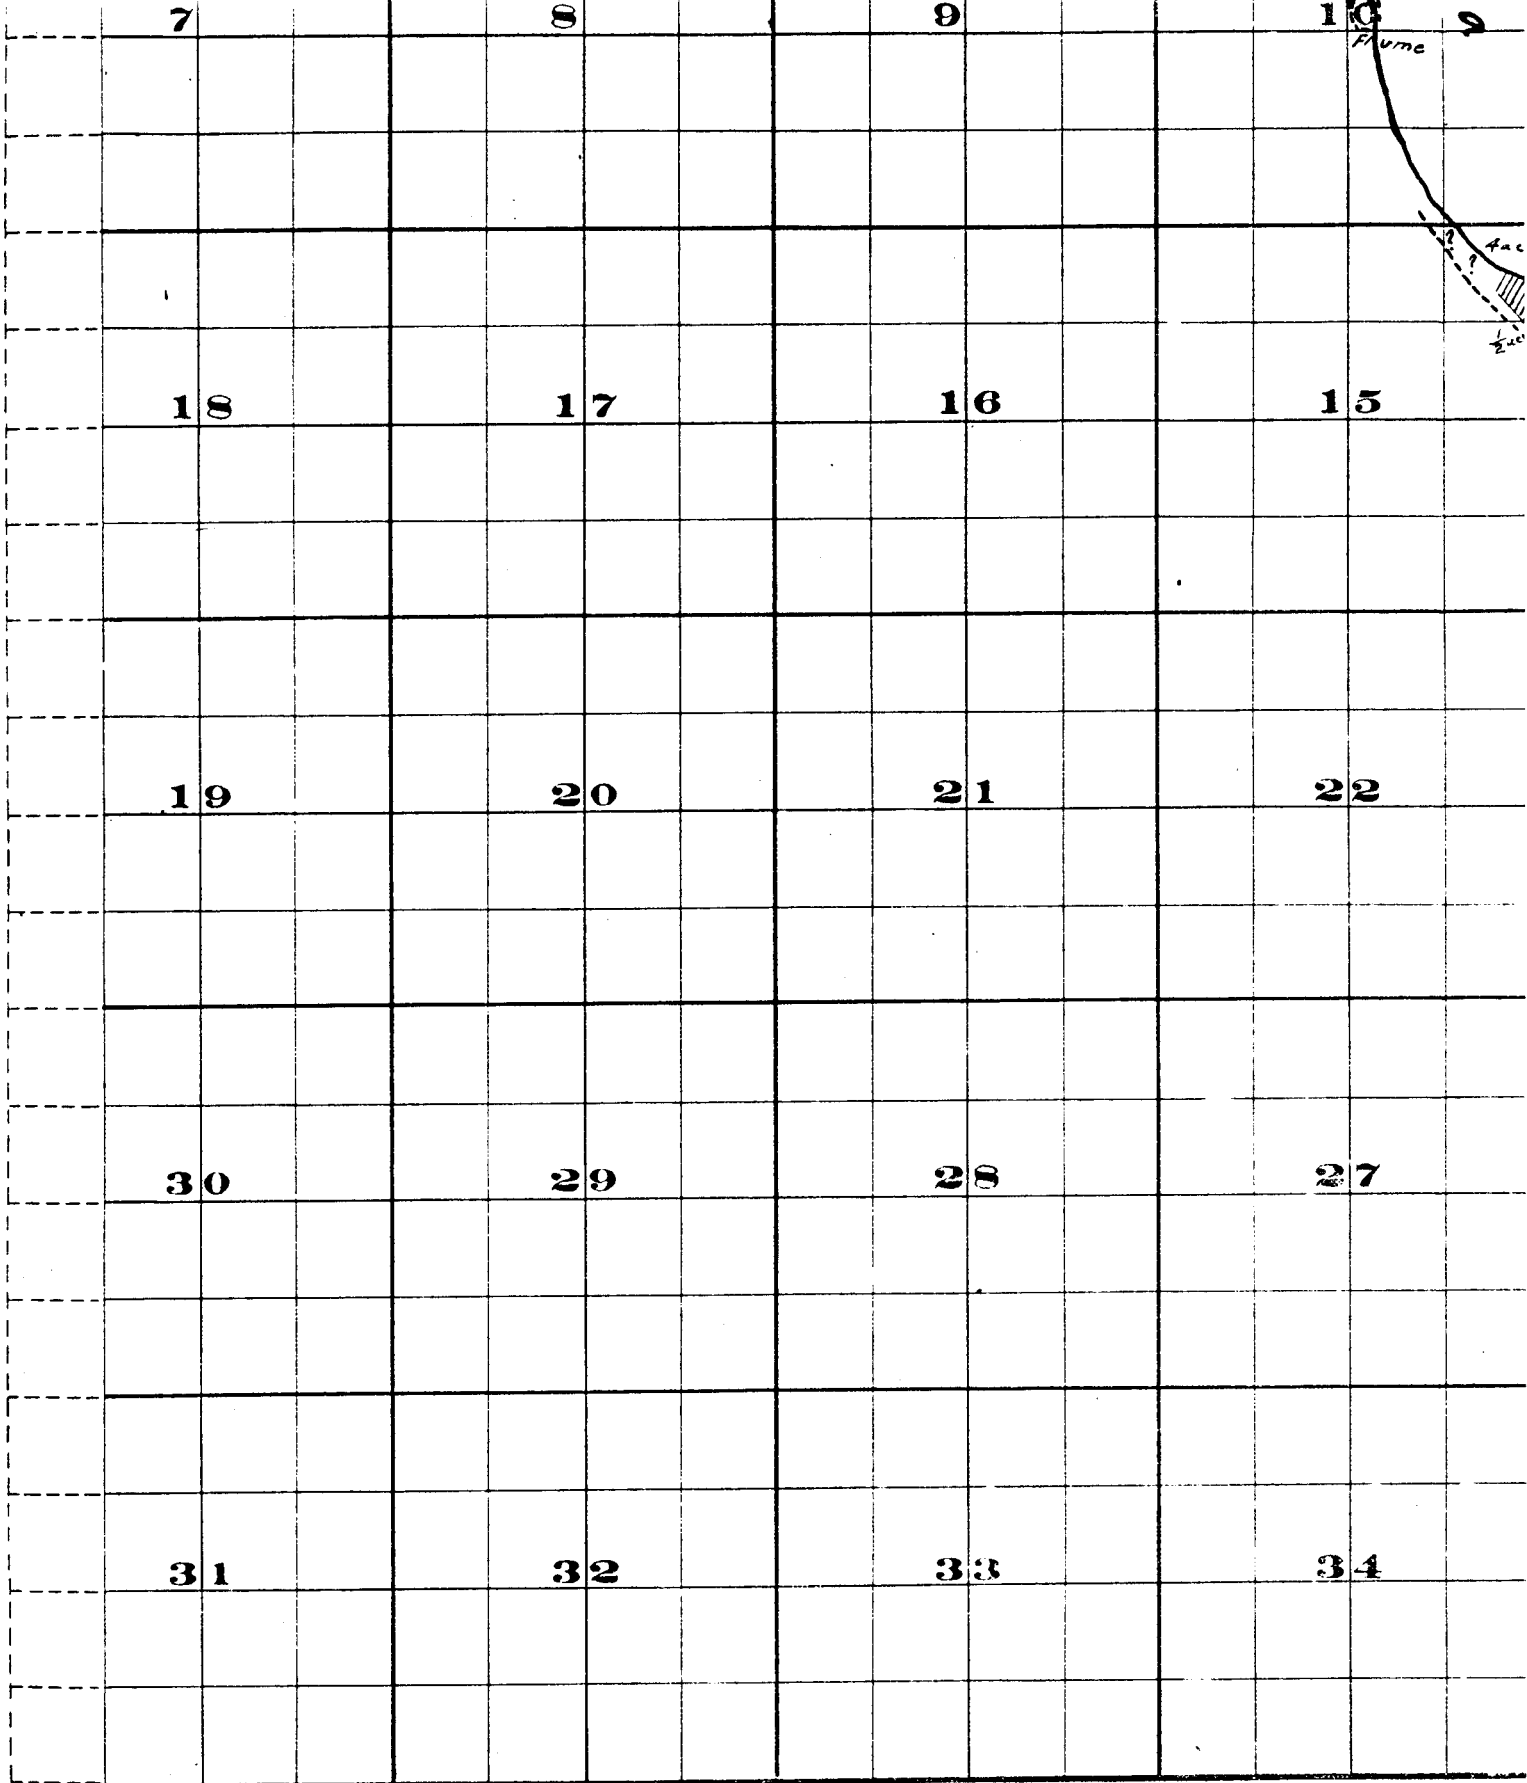



Surveyed by H. K. Donnelly July 1909

John H. Lewis - State Engineer

Examined July 14, 1909.

Township 4 S.

,

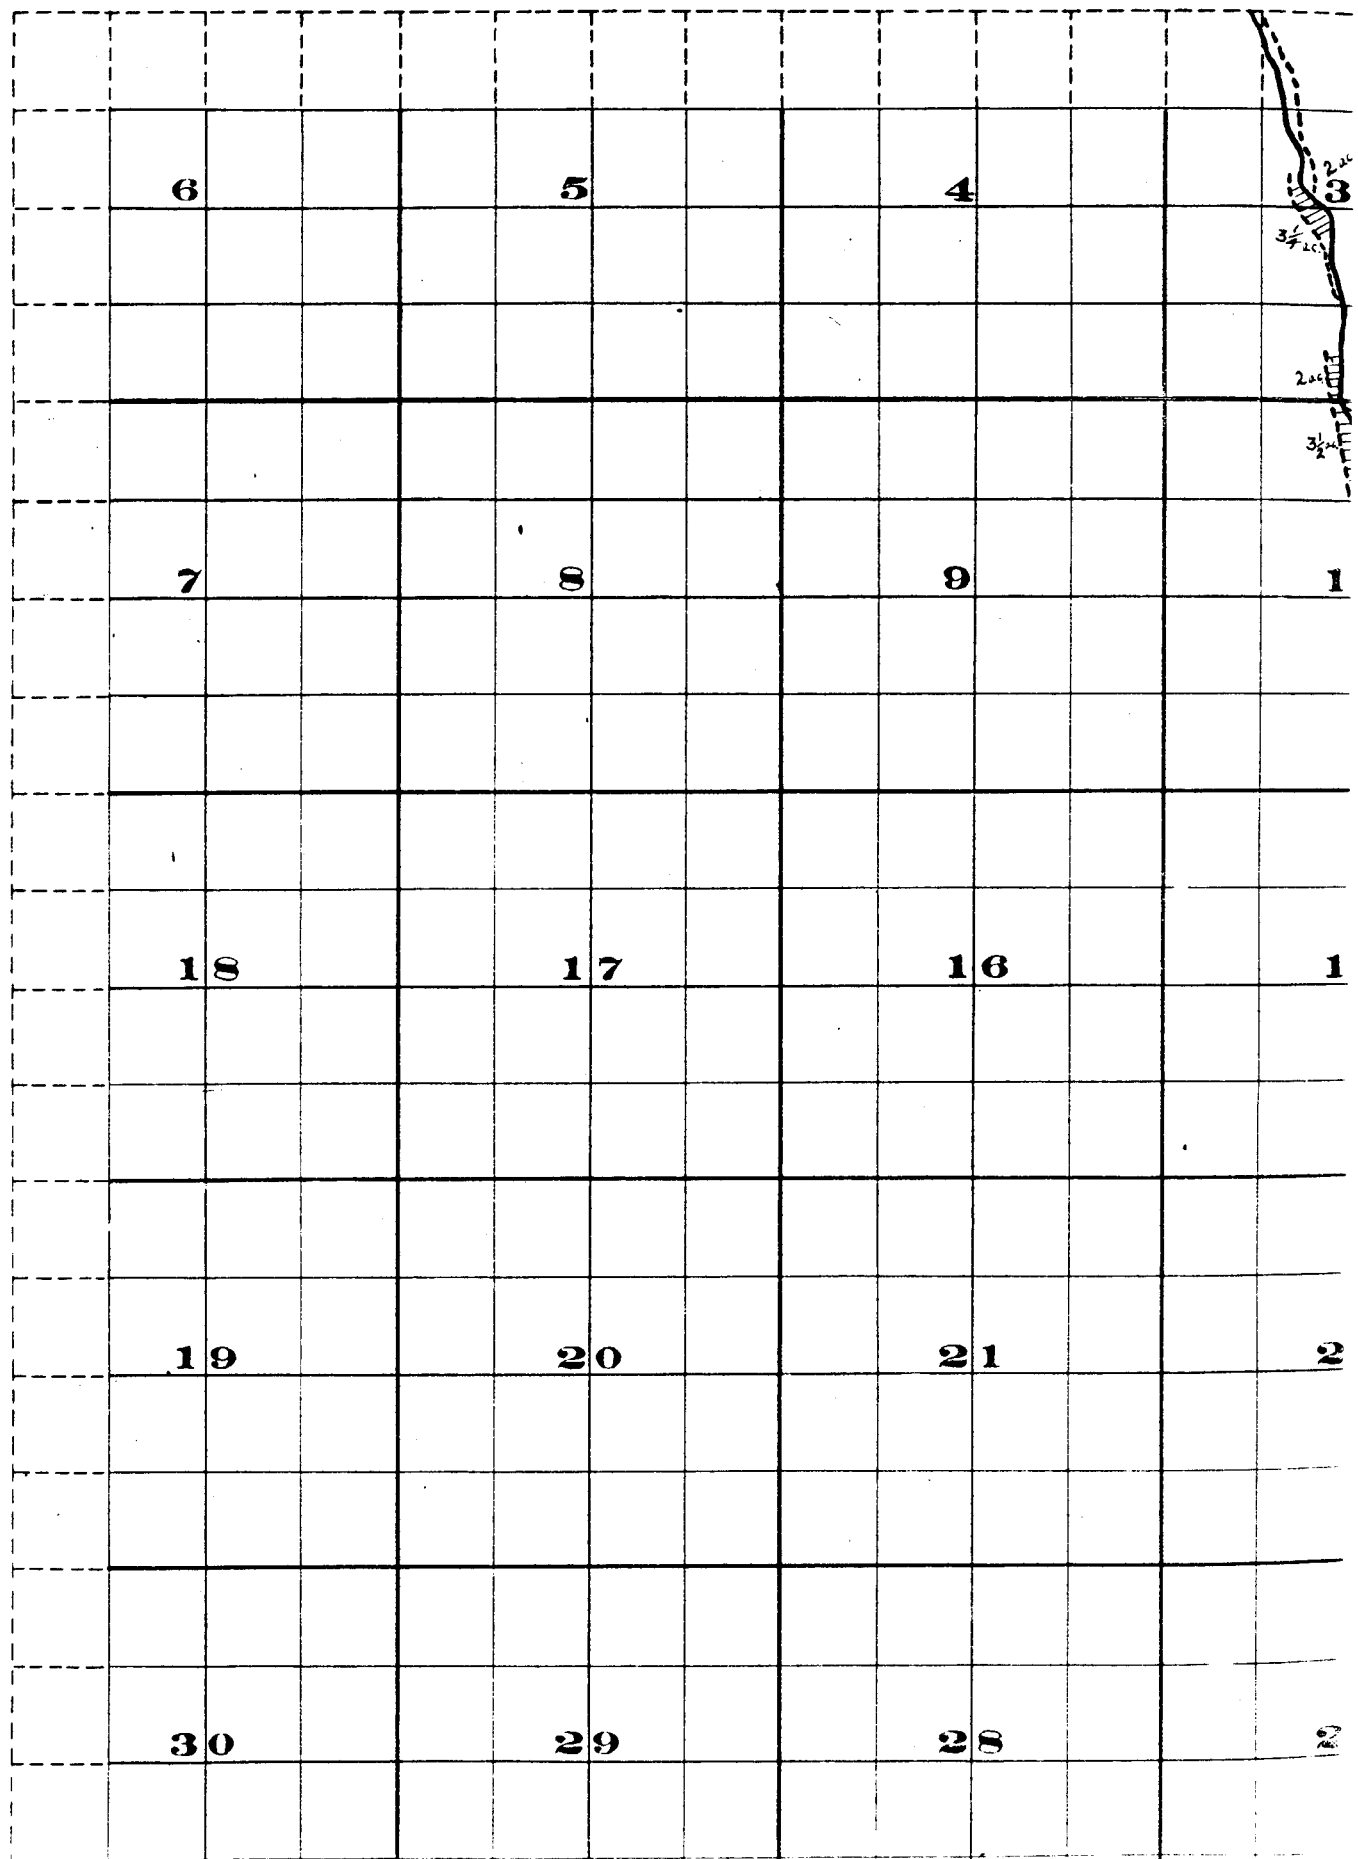

5.

