


Per 21829
21828
21499
21500

T. 8S. R. 30E. W.M.

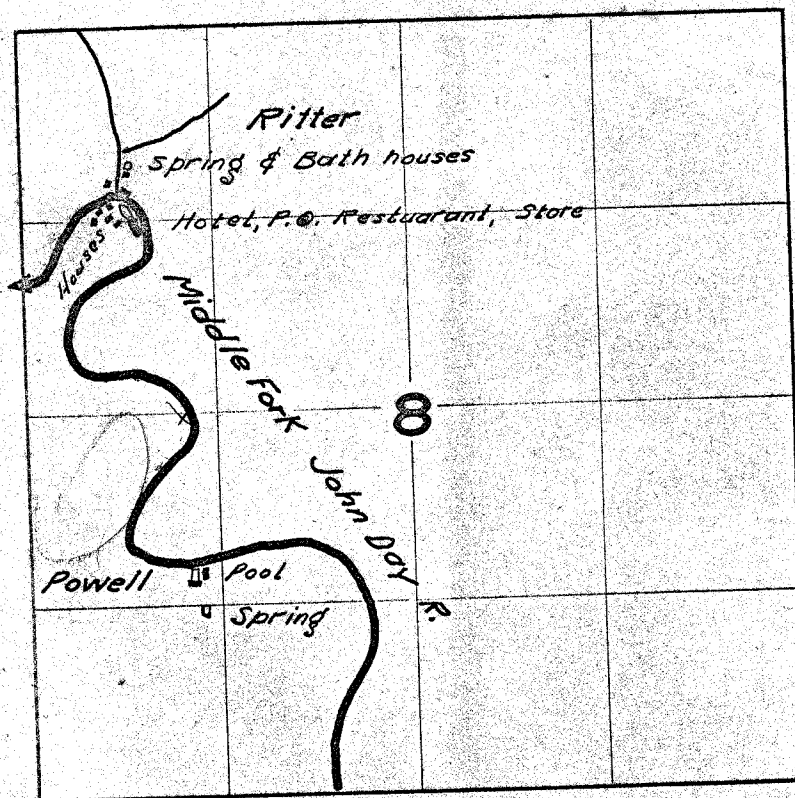

FINAL PROOF SURVEY

UNDER

28053

21829

Application No. 28052

Permit No. 21828

IN NAME OF

Ritter Hot Springs

Surveyed Aug. 26 1954, by H. L. Coffman

BTU-24-34
Pantograph