


23

T. 38 S., R. 4 W., W.M.

Scale: 8 inches = 1 mile

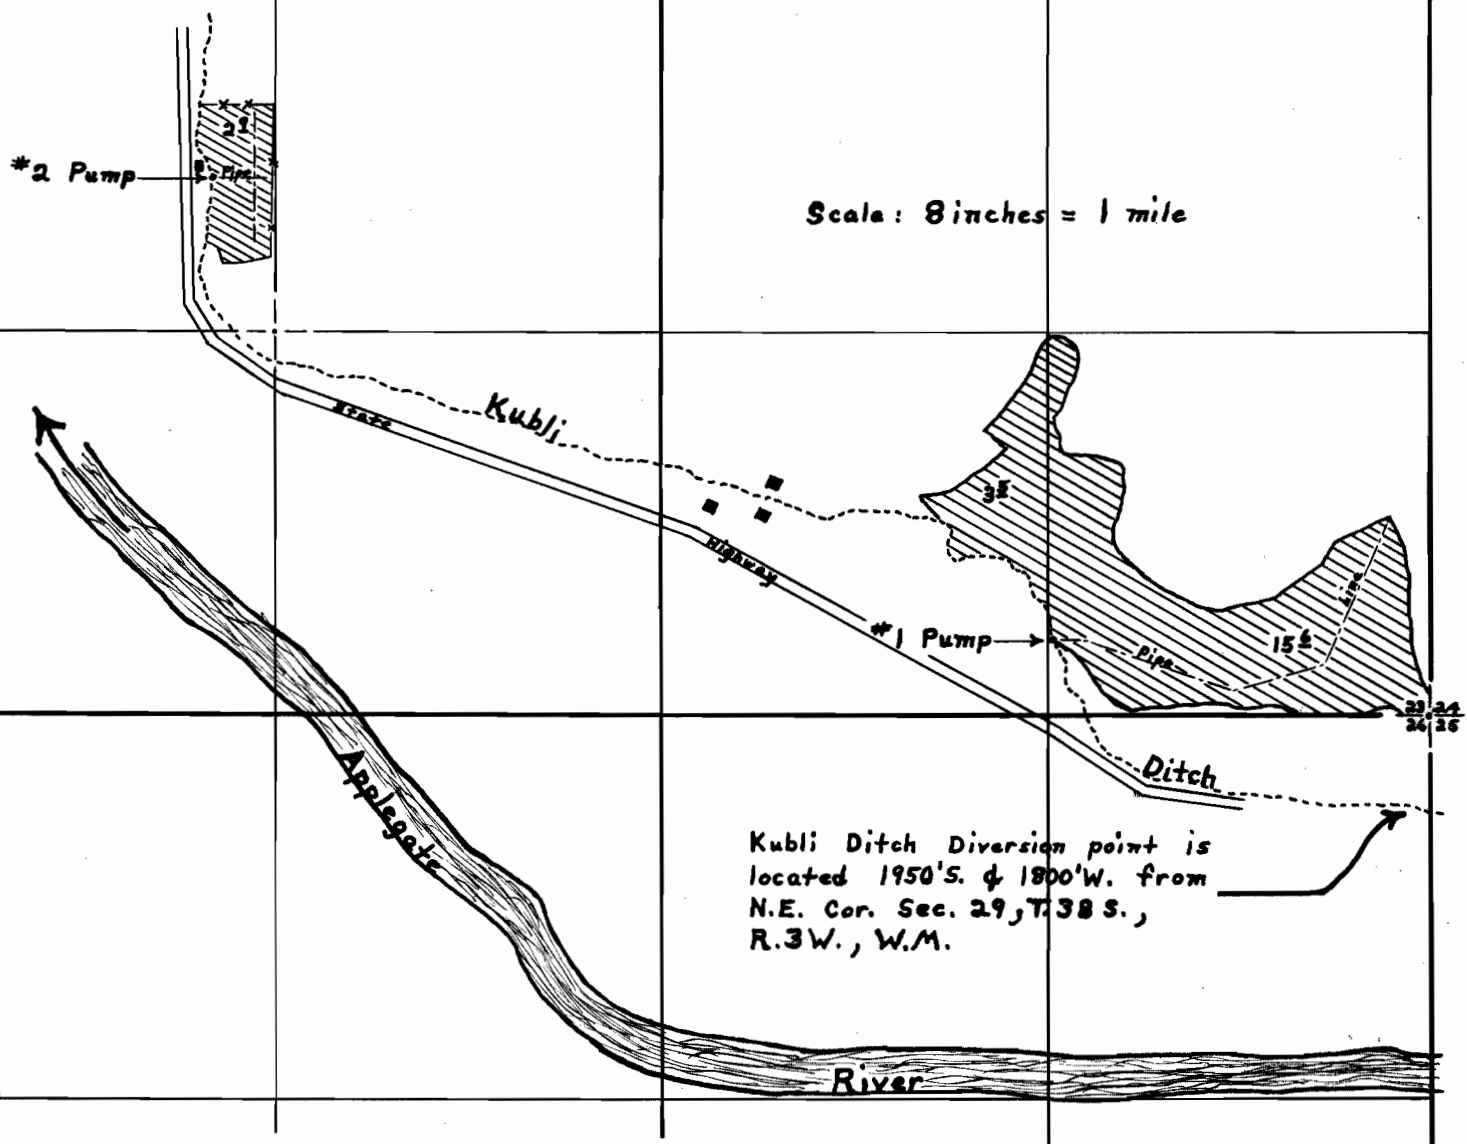

# FINAL PROOF SURVEY

UNDER

Application No. 29301... Permit No. 23331...

IN NAME OF

E. W. Kubli

Surveyed ~~March 27, 1930~~ 1956, by David C. Hendrix