


T.18S.R.6W.W.M.

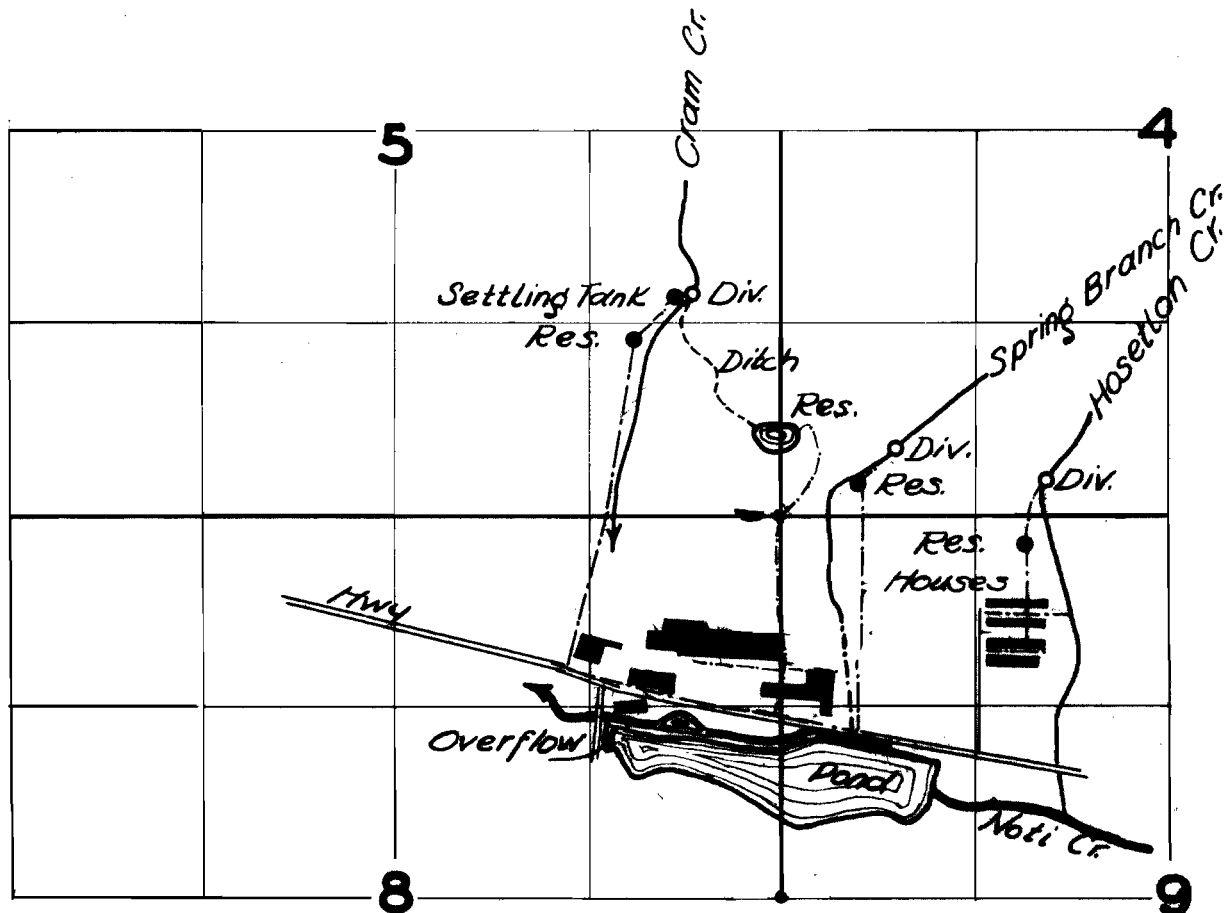

FINAL PROOF SURVEY

R-24731 R-1042

R-24729 R-1041

R-24732 R-1043

Application No. 24733 Permit No. 12502

IN NAME OF

The Long-Bell Lumber Co., Vaughn Div.

Surveyed April 28 1954, by H. L. Coffman

DBA-8H-172