


SURVEYOR'S CERTIFICATE

I, W.E. Anderson of Tillamook, Ore do hereby certify that this map was made from notes taken during an actual survey made by me in July 1953 and that the monuments and storage basin are correctly located with a tie to the N.E. COR SEC 22, T.14 N. R.10. W. W.M

W.E. Anderson
Co. Surv.

15 14

22 23

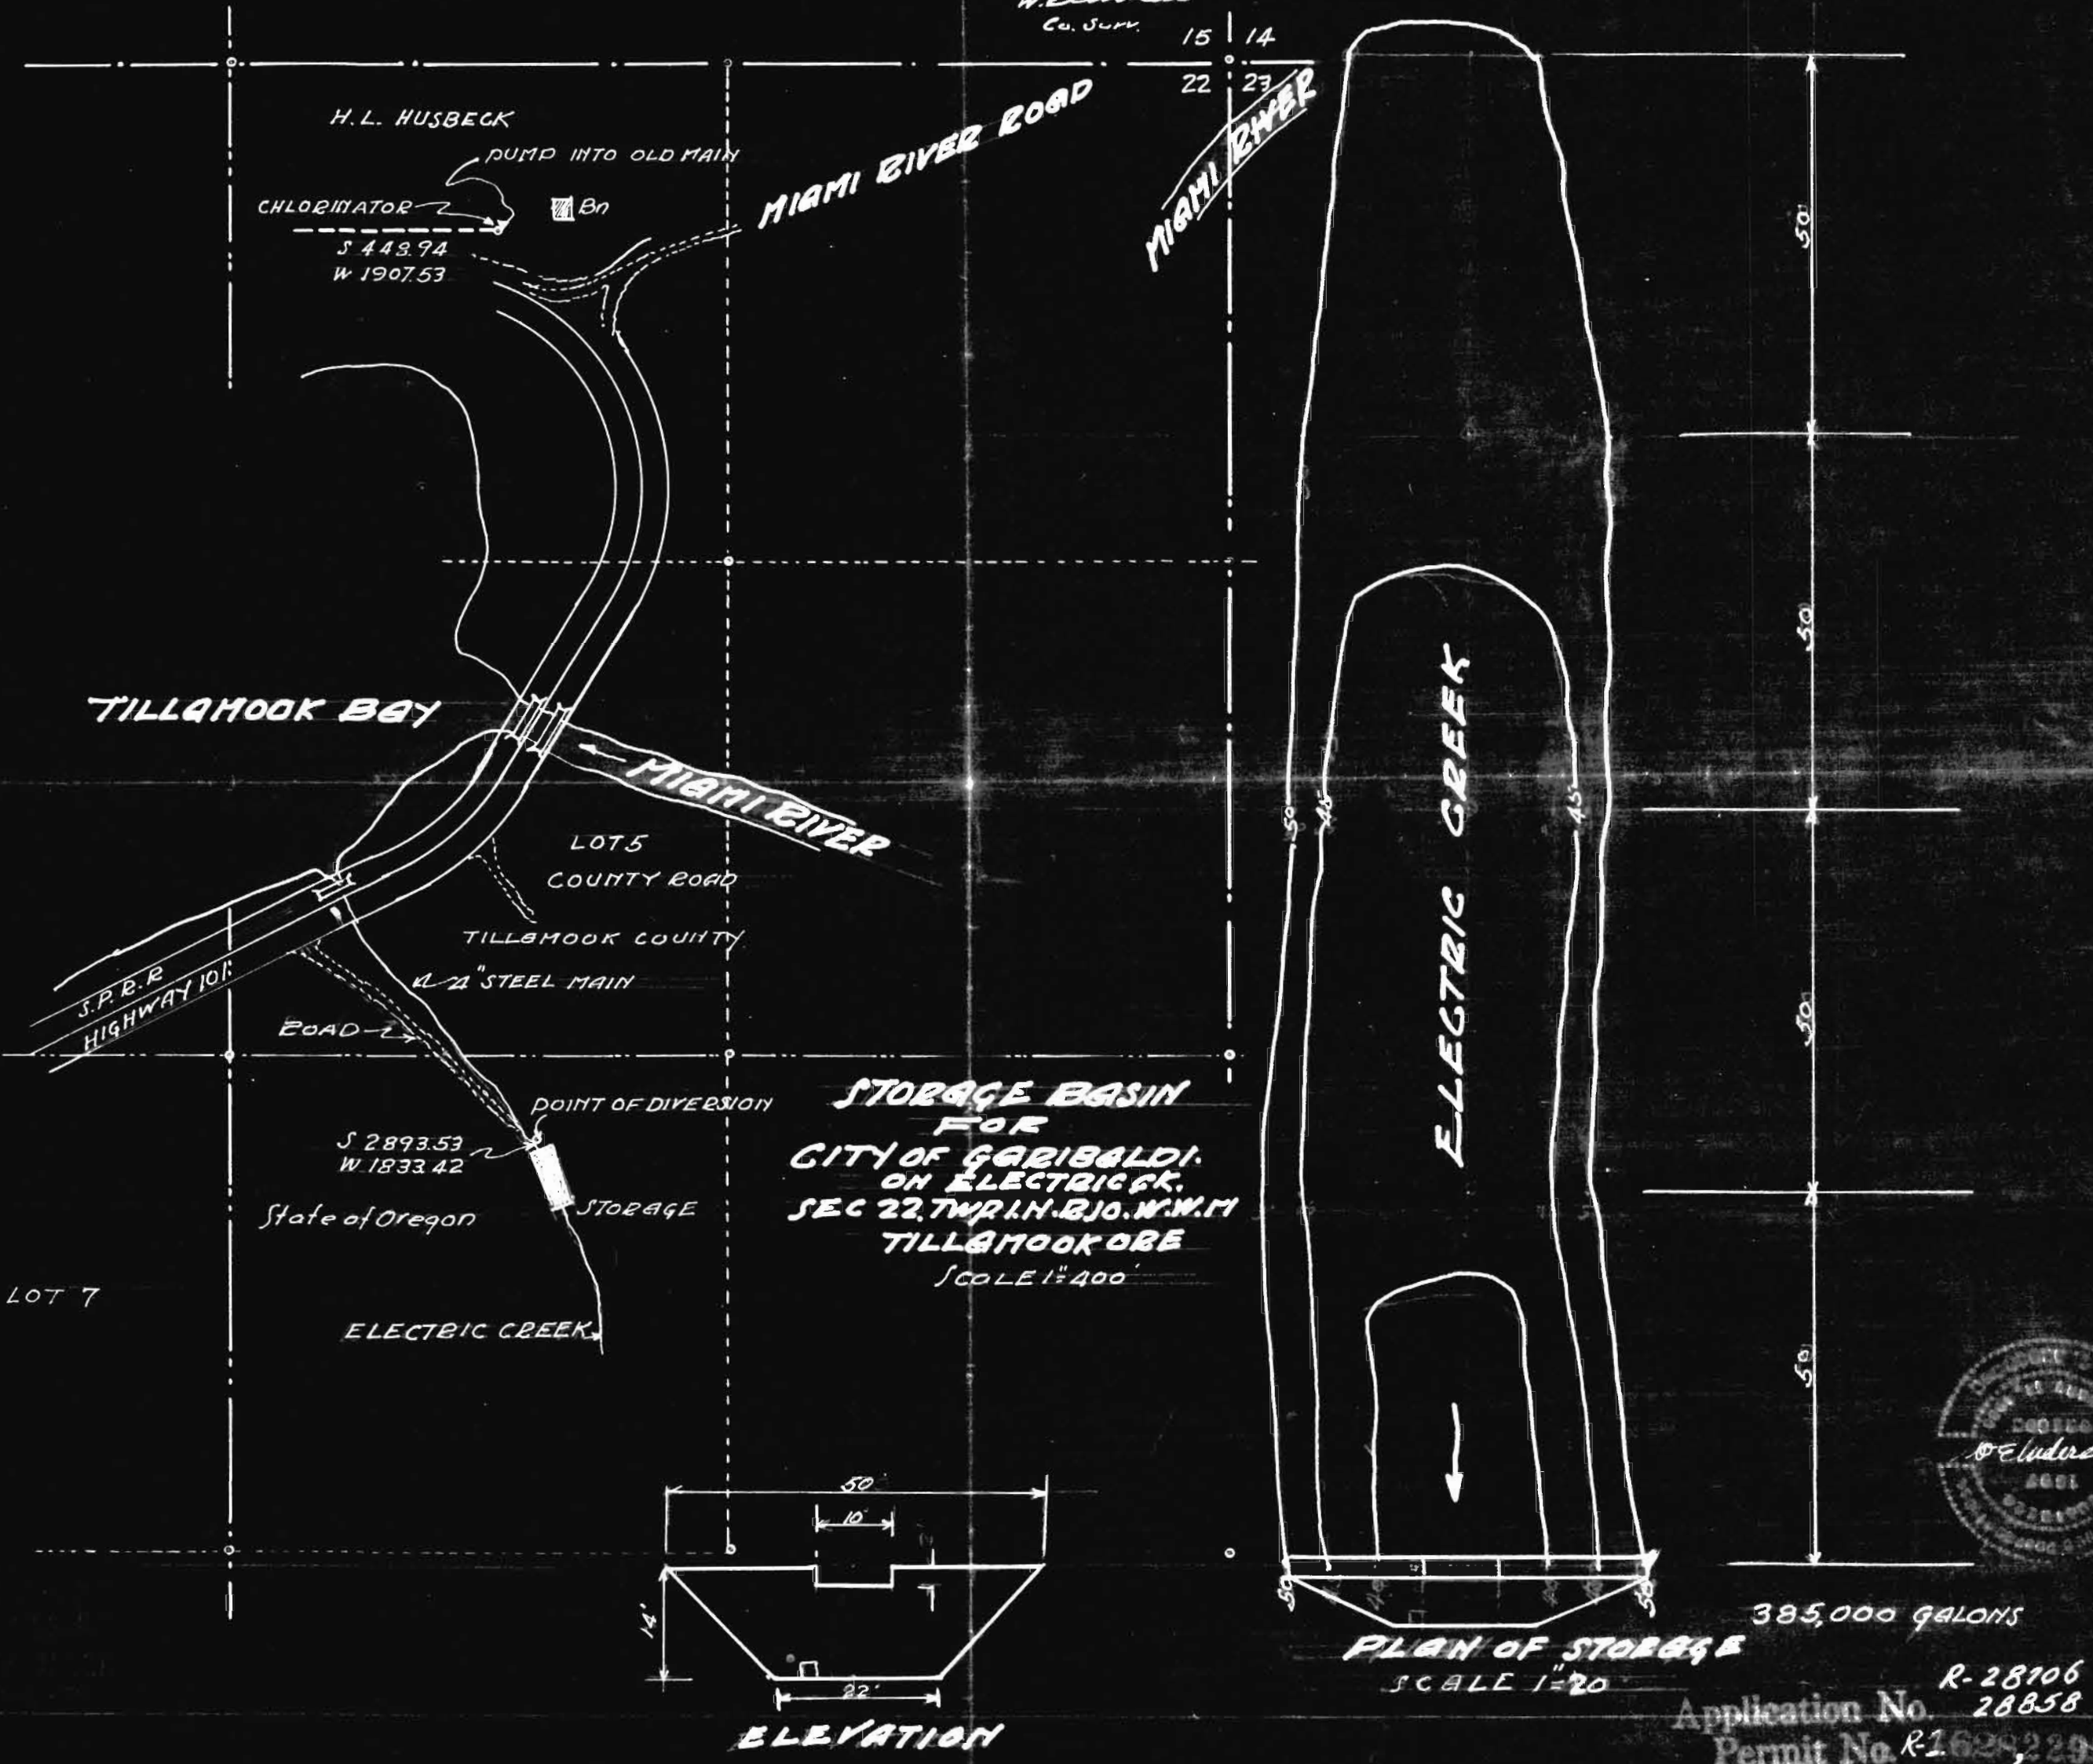

Application No. R-28106
28858
Permit No. R-16292295