


T. 3 N. R. 10 W. W. M.

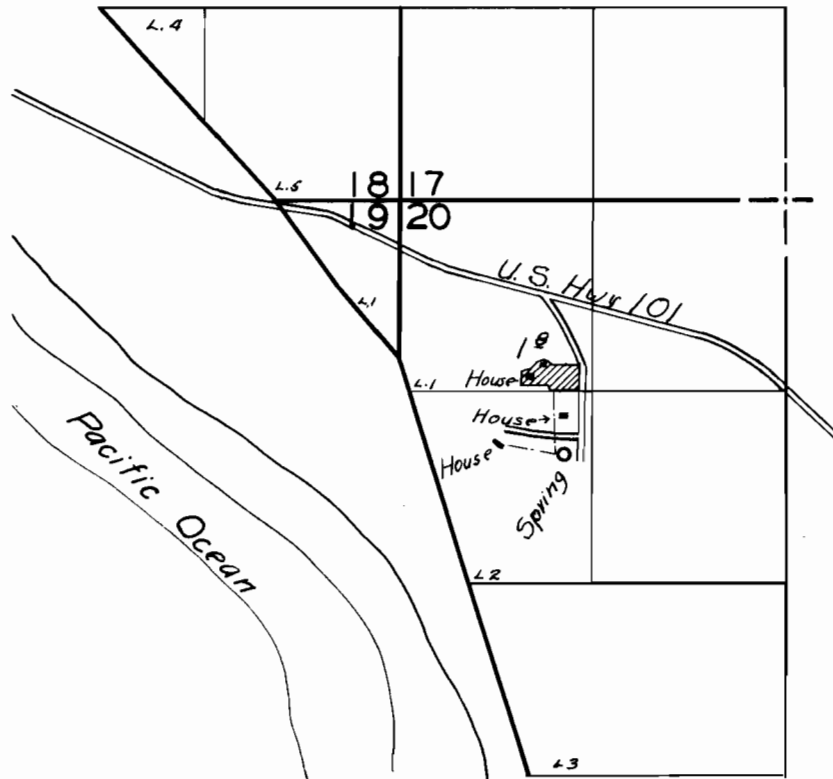

FINAL PROOF SURVEY
UNDER

Application No. 18797 Permit No. 14438
IN NAME OF

JOHN & KATHRYN SCHIBEL

Surveyed 4 August 1955, by *Robert H. Reed*