


# T. 1 S. R. 9 W. W. M.

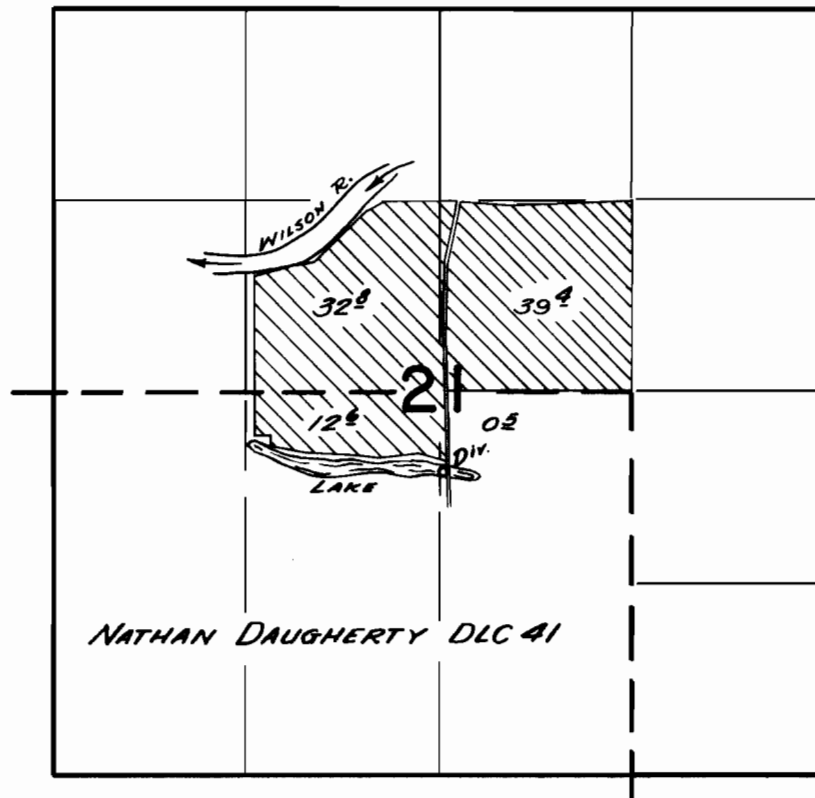

## FINAL PROOF SURVEY UNDER

Application No. 23127 Permit No. 18261  
IN NAME OF

HART BROS.

Surveyed July 13 1961, by M. Bish