


T. 15, R. 38 & 39 E. W.M.

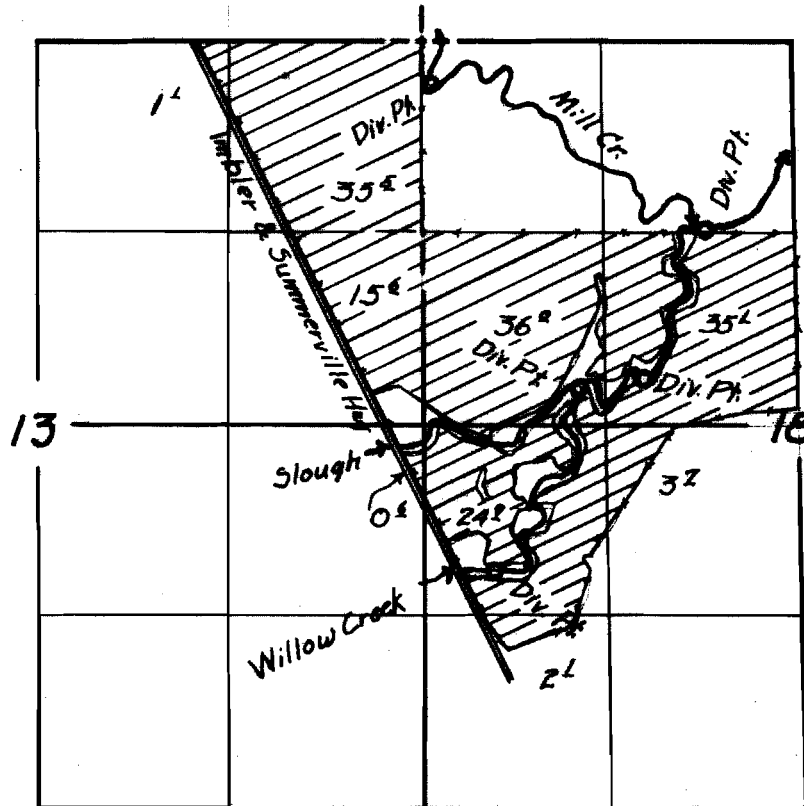

**FINAL PROOF SURVEY**

UNDER

Application No. 23956 Permit No. 18909

IN NAME OF

**KIETH GLENN**

Surveyed ~~25 October~~ 1955, by *Robert H. Reed*