


T29SR12WWM

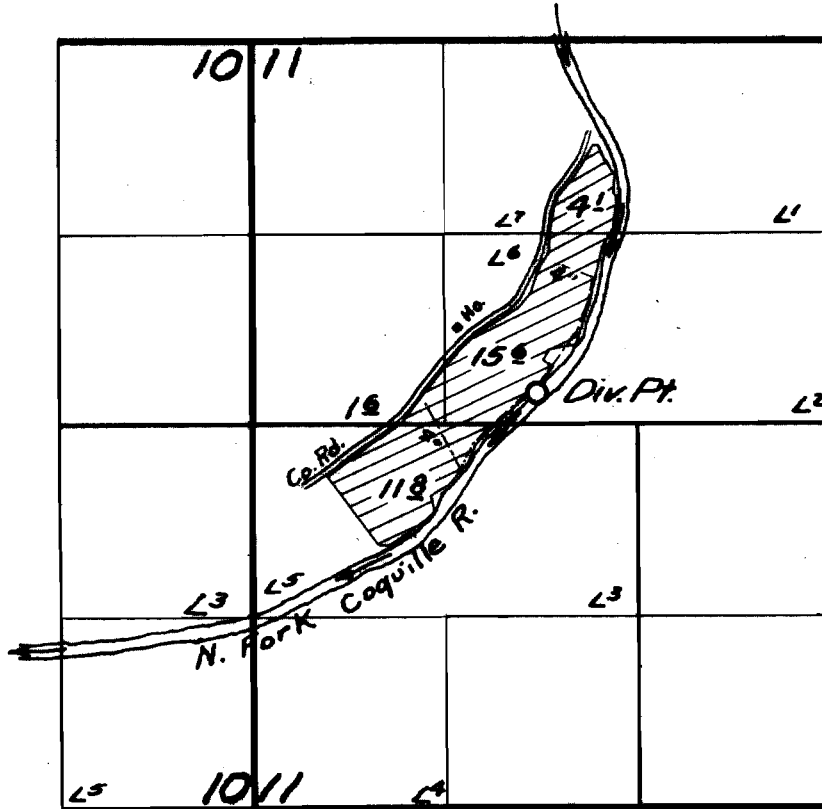

**FINAL PROOF SURVEY**

UNDER

Application No. 24343 Permit No. 19135

IN NAME OF

H.F. McNAIR

Surveyed Aug 24 1955, by M. B. B.