


T.3S. R. 8 W.W.M.

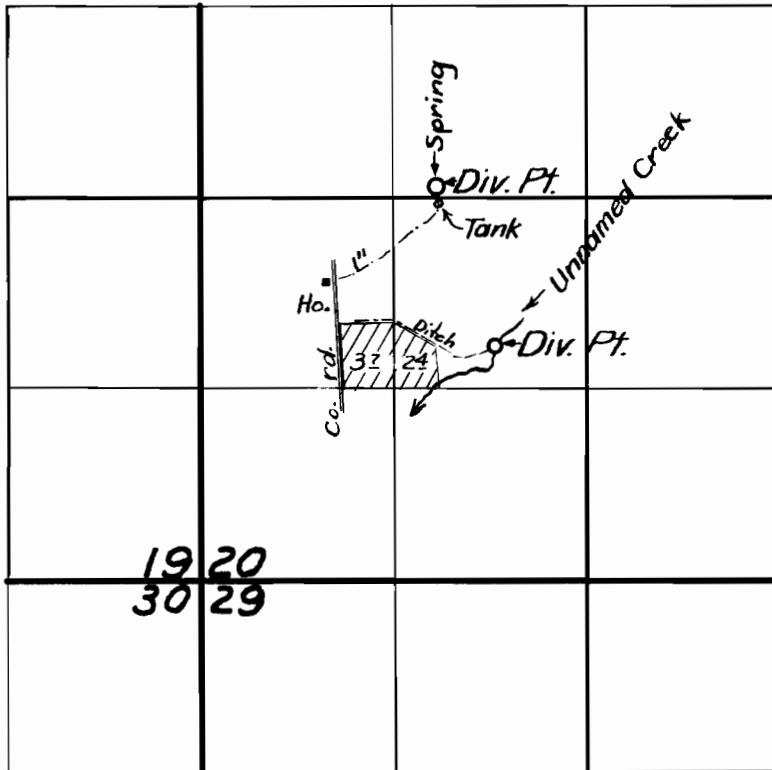

19 20
30 29

FINAL PROOF SURVEY
UNDER

Application No. 24581 Permitt No. 19372
IN NAME OF

EARL RAY WOODS

Surveyed Sept. 8th 1955, by M. Bish