


T.3 N.R. 10 W.W.M.

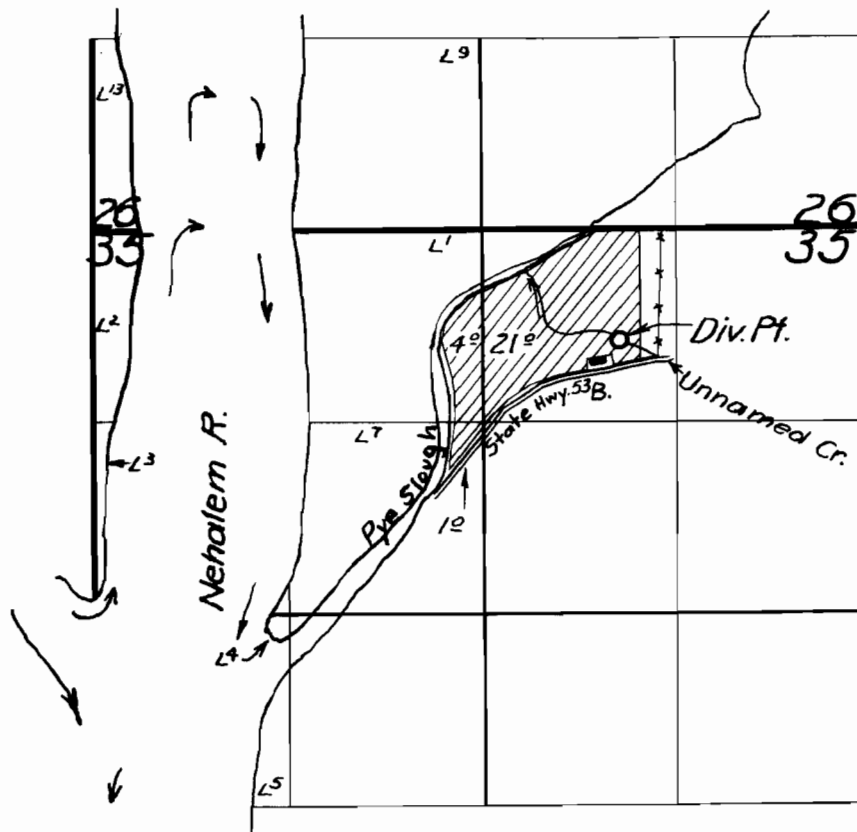

FINAL PAC OF SURVEY
UNDER

Application No. 24890 Permit No. 19682

NAME OF

FRANK JUD

Surveyed Sept 20 1955, by Wm. B. Bish

1955 M