


T.35, R.3W.W.M.

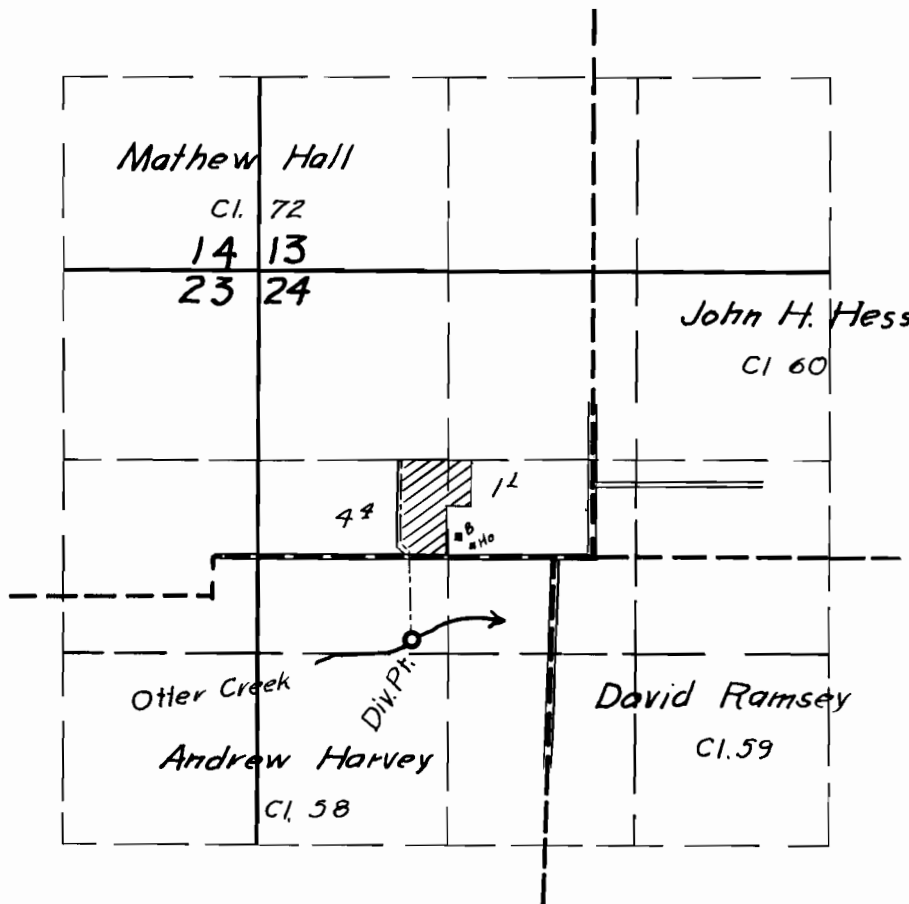

FINAL PROOF SURVEY
UNDER

Application No. **25003** . Permit No. **19706**
IN NAME OF

ROY & MAUDE MARSHALL

Surveyed **30 Sept. 1955** . by *Robert H. Reed*