


T29SR11WWM

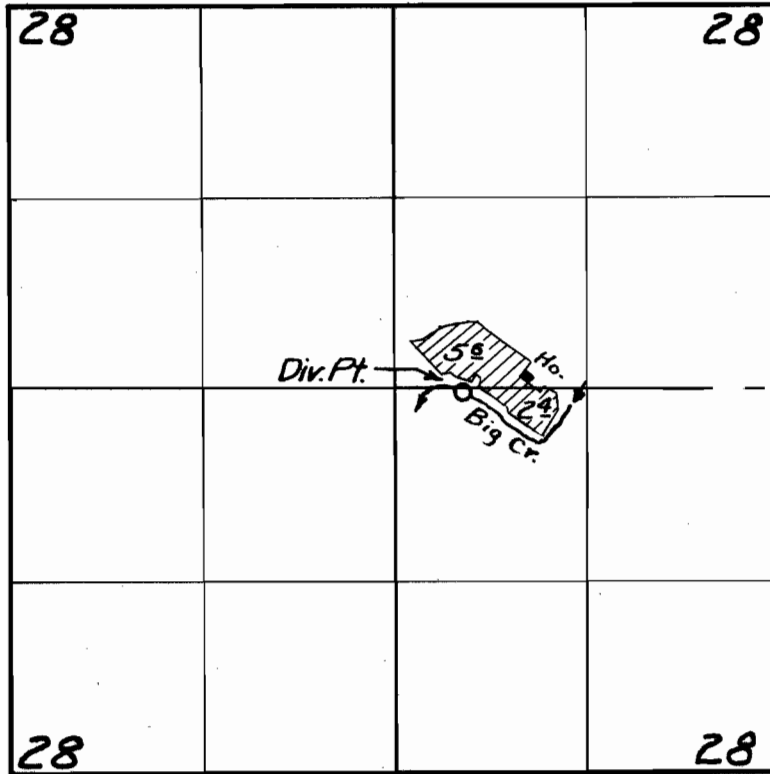

FINAL PROOF SURVEY

UNDER

Application No. 25125 Permit No. 19768

IN NAME OF

Frank I. Downing

Surveyed Aug 24 1955, by M. Bish