


T. 4 S. R. 10 W. W.M.

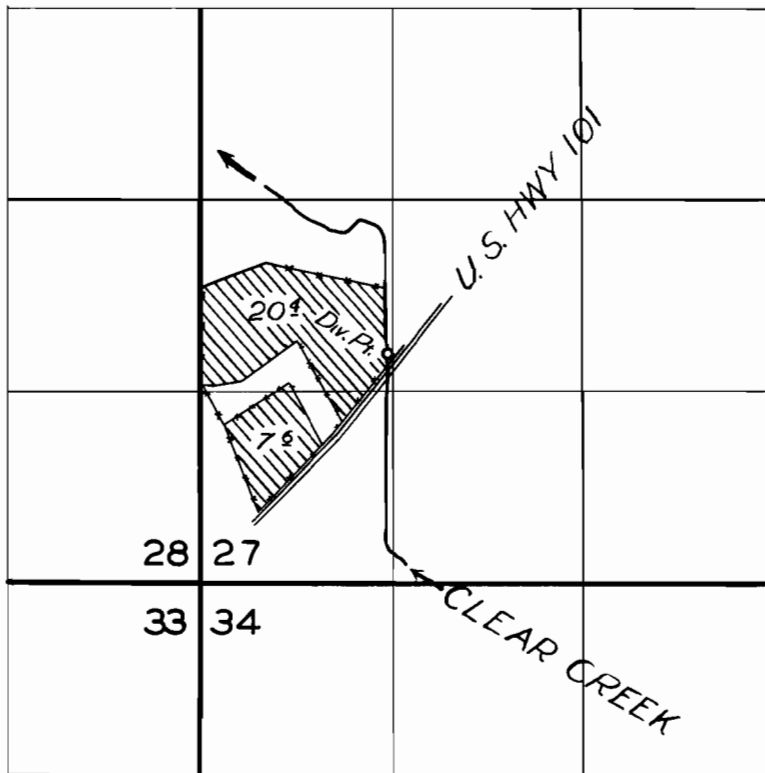

FINAL PROOF SURVEY

UNDER

Application No. 25812 . Permit No. 20282

IN NAME OF

JOHN NIEDERER

Surveyed 12 Aug 1955, by

1955-E