


T.17S. R.6W.W.M.

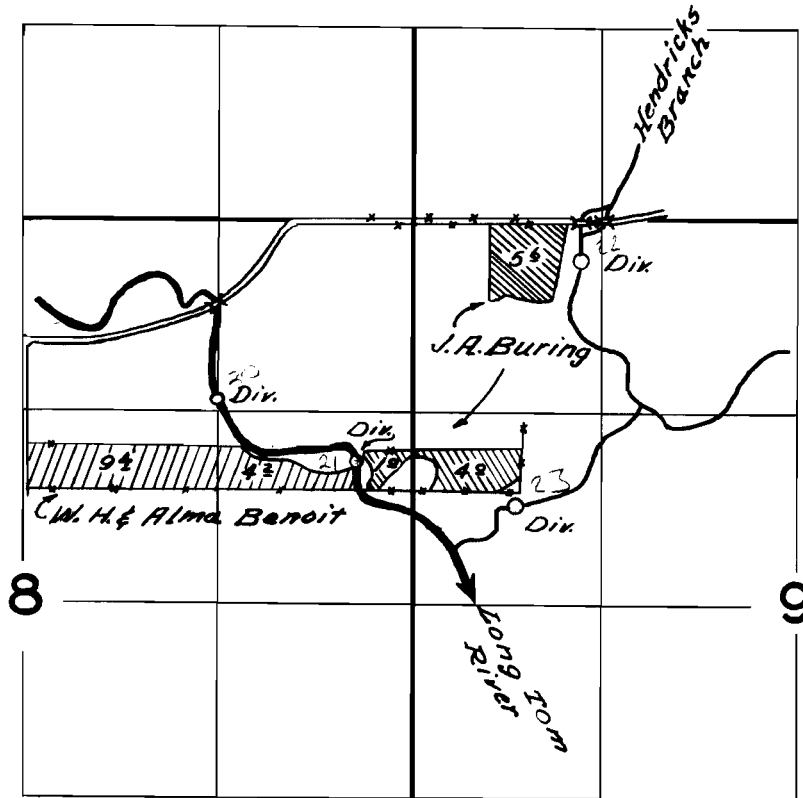

FINAL PROOF SURVEY

UNDER

Application No. 22869 . Permit No. 18052

IN NAME OF

W. H. & Alma Benoit & John A. Buring

Surveyed *May 11* April 27 1954, by *H. L. Coffman*