


T. 9S.R. 2&3 W.W.M.

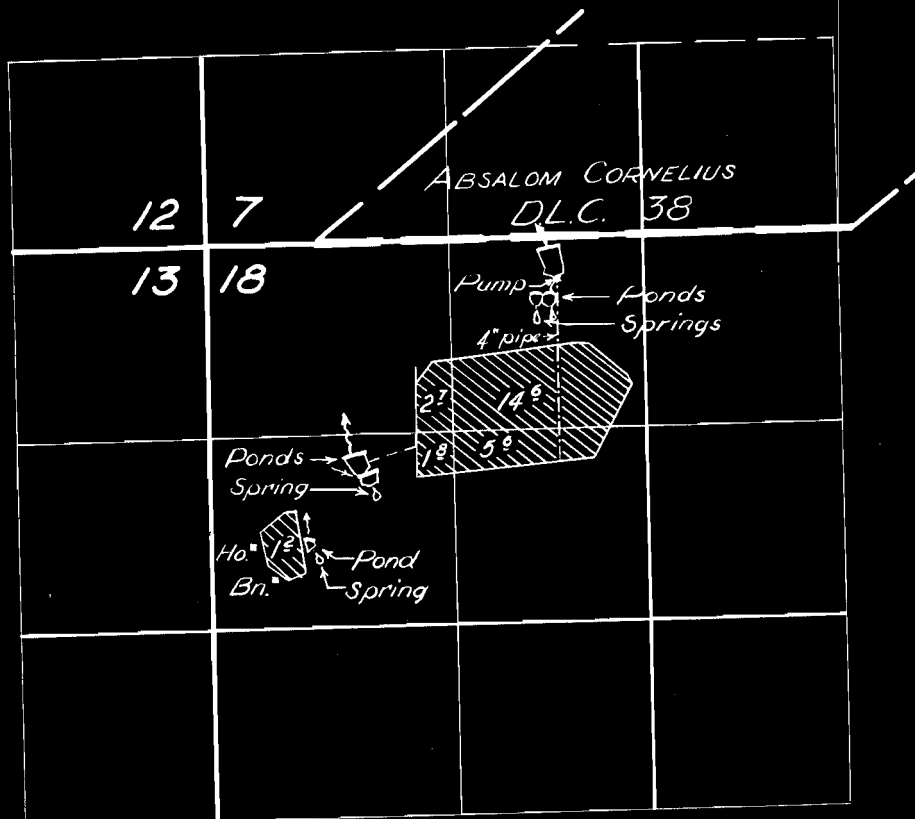

FINAL PROOF SURVEY

UNDER

21678

17022

Application No. R-21677

Permit No. R-844

IN NAME OF

E. E. FRITZ

Surveyed 8 Apr. 1955, by T. JONES

1955-Y