


App 4847
Per 2900

TP92 R35 E. W.M.

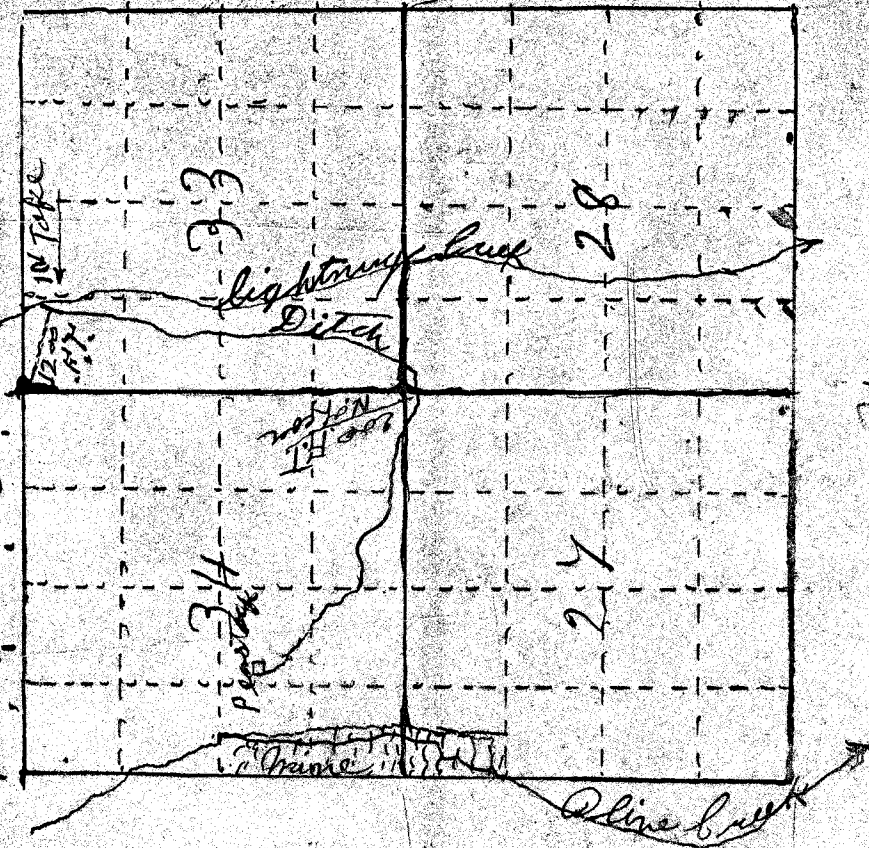

Application No. 4847
Permit No. 2900

25

25

26

53

3