


T.3N.R.10W.W.M.

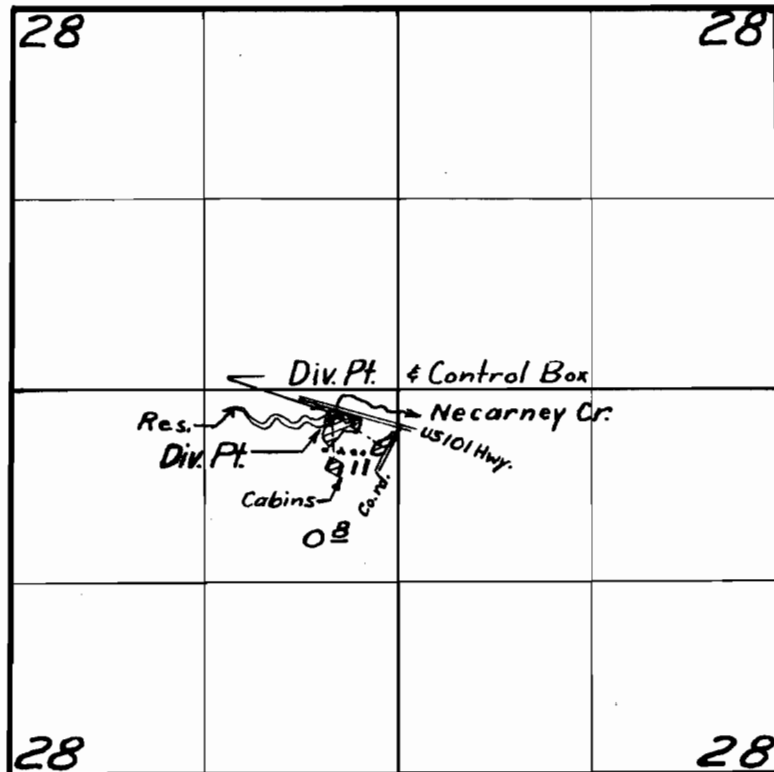

FINAL PROOF SURVEY

UNDER

R-23362

R-946

Application No. 23363 Permit No. 18403

IN NAME OF

K.A. BANKS

Surveyed Sept 22 1955, by M. B. Bish

1955N