
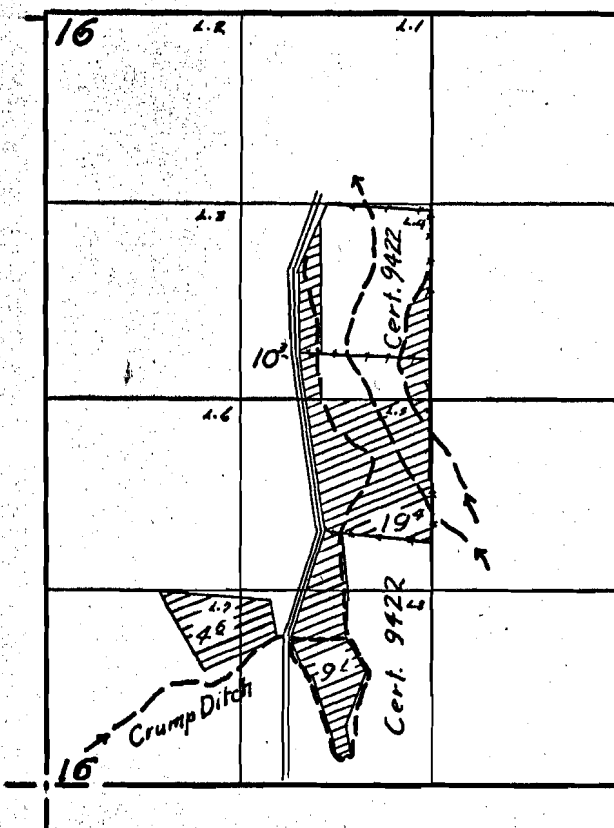


18684

21574

T.39S, R. 23E.W.M.

T.39S, R. 24E.W.M.

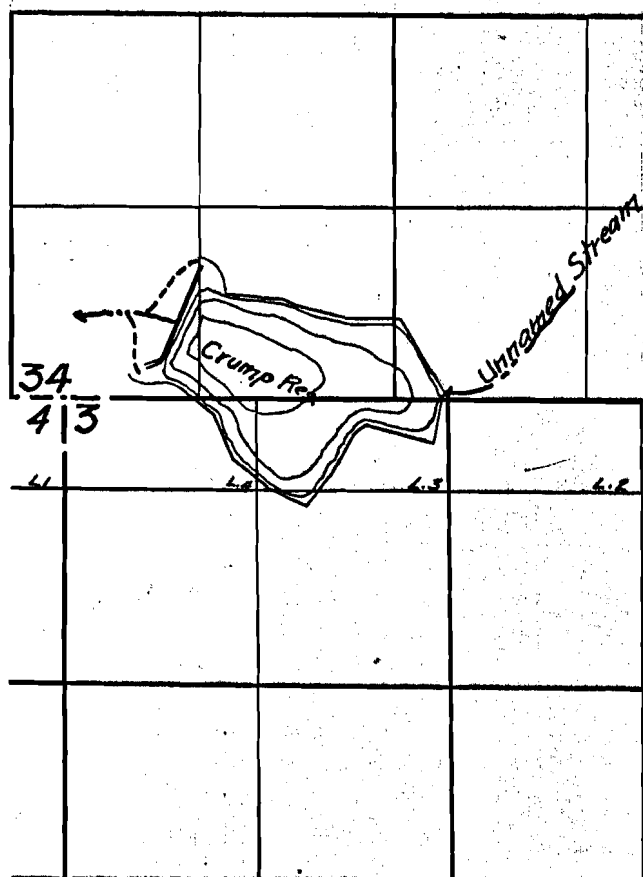

FINAL PROOF SURVEY

UNDER

R-23581

R-969

Application No. 23582... Permit No. 18684...

IN NAME OF

CHARLES A. CRUMP

Surveyed 2 October, 1955, by *Robert H. Beck*

39723,24

1955 U.