
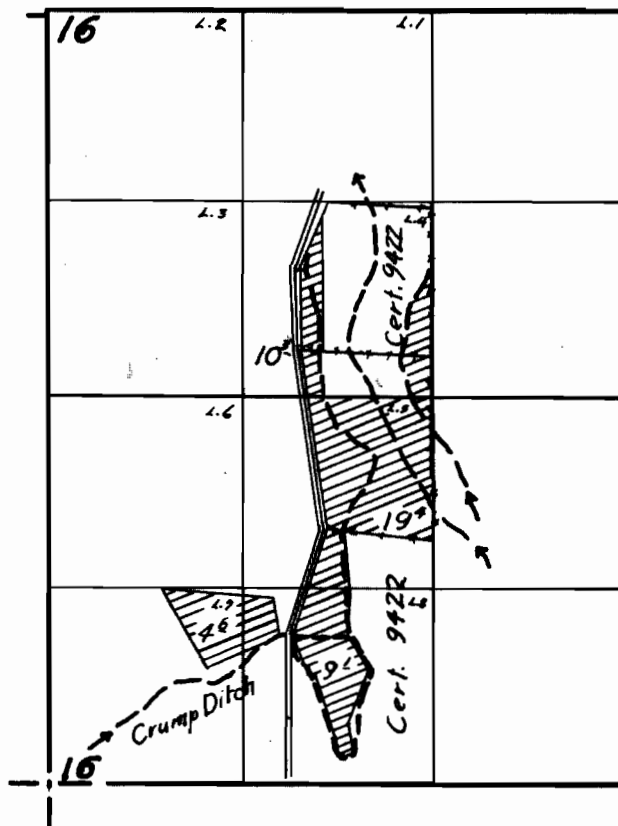


T.39S, R. 23E.W.M.

T.39S, R. 24E.W.M.

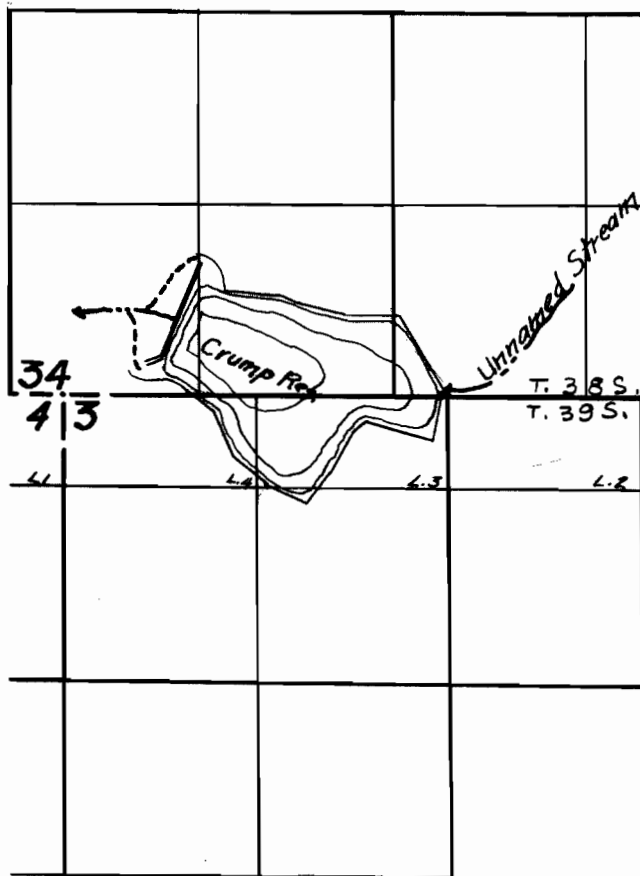

FINAL PROOF SURVEY

UNDER

R-23581

R-969

Application No. 23382... Permit No. 18884...

IN NAME OF

CHARLES A. CRUMP

Surveyed 9 October 1955, by Robert H. [Signature]