


Per 18898
R-988
21577
21576

T. 11 S. R. 35 E. W. M.

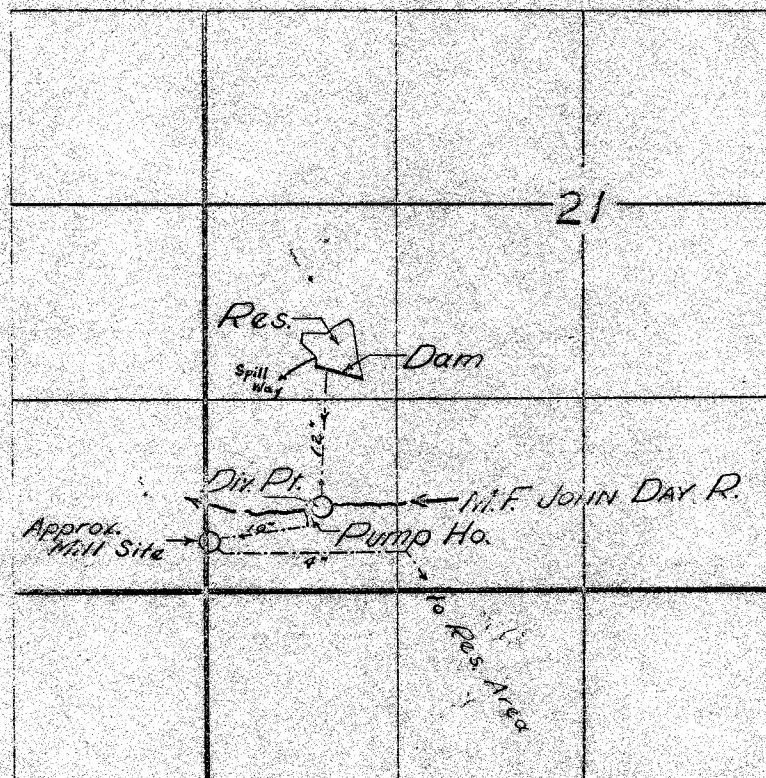

FINAL PROOF SURVEY

UNDER

R-23898

R988

Application No. 23899 Permit No. 18898

IN NAME OF

OREGON LUMBER COMPANY

Surveyed 18 Oct. 1955, by

[Signature]

1955-E