


Application No. R-24520 and 24521.
 Permit No. R-1022 and 19354.

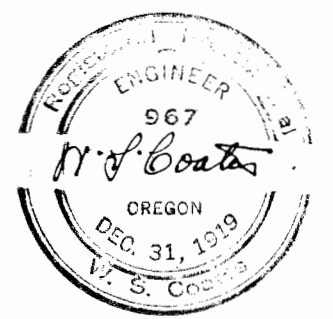

I, W. Stanley Coates of Tillamook, Oregon do hereby certify that this map was made from notes taken during an actual survey made by me on May 8, 1950 and that the center of the concrete dam is North 219.8 ft & East 3265.9 ft from the 7 Sec. Cor. between Secs 7 & 8, T15, R9W, W.M.

W. Stanley Coates

**TILLAMOOK COUNTY
 CREAMERY ASSOCIATION
 WATER RIGHT
 SEC. 8, T15, R9W, W.M.
 TILLAMOOK COUNTY, ORE.
 SCALE 1"=800'**

RECEIVED
 STATE ENGINEER
 SALEM, OREGON