


T. 3 S. R. 3 W. W. M.

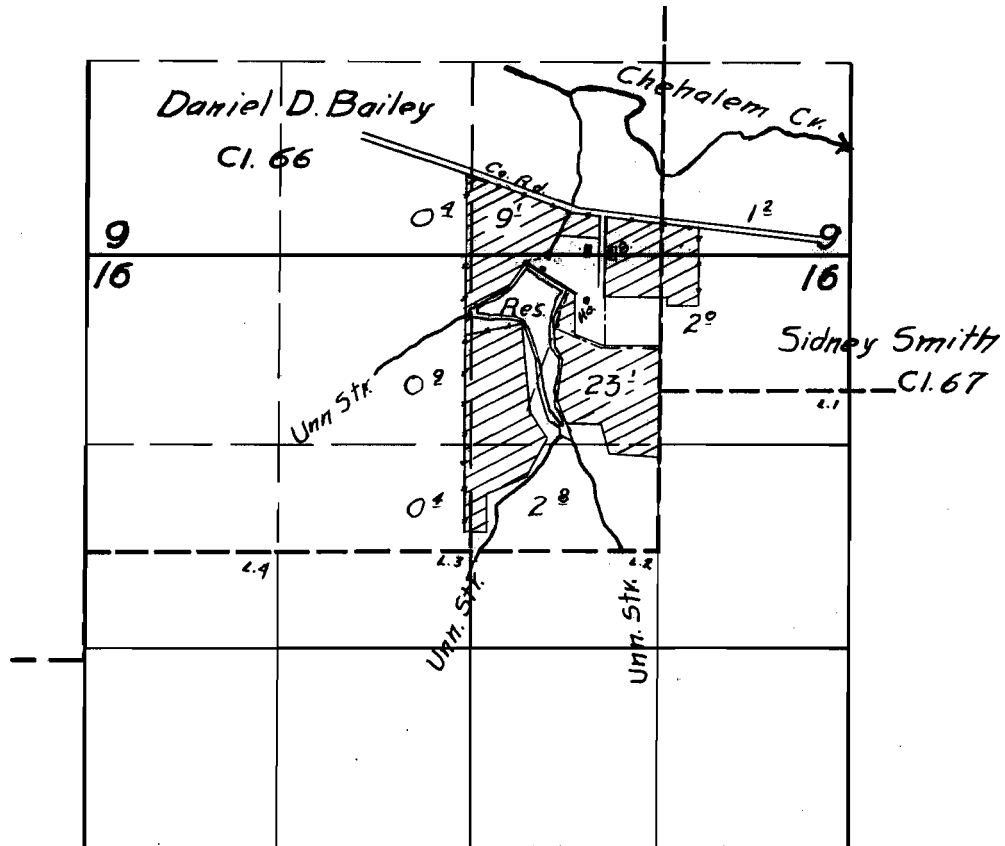

**FINAL PROOF SURVEY**

UNDER

R-26645 R-1280  
Application No. 26646 Permit No. 20872

IN NAME OF

MARINUS VANDEN HOEK

Surveyed 29 Sept. 1955, by [Signature]