



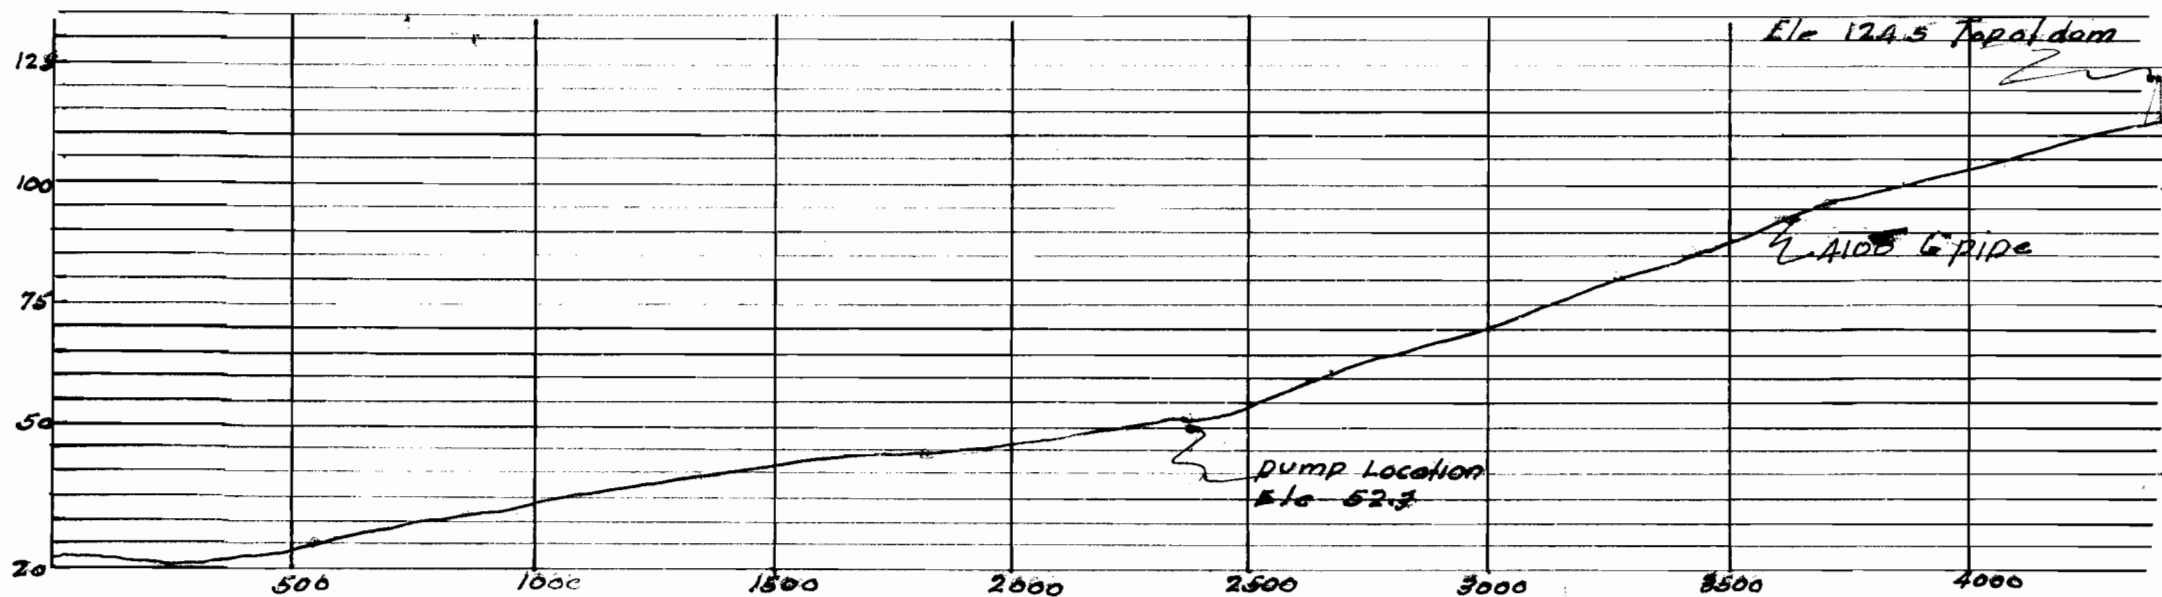

I, W. E. Anderson of Tillamook Ore do hereby certify that this map was made from notes taken during an actual survey made by me in Oct 1954 and that the monuments shown are with reference to the S.E. cor SW $\frac{1}{4}$ of NW $\frac{1}{4}$ Sec 35

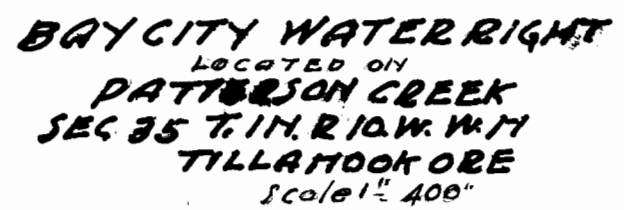

Application No. _____
Permit No. _____

R-26690
26691
124387