

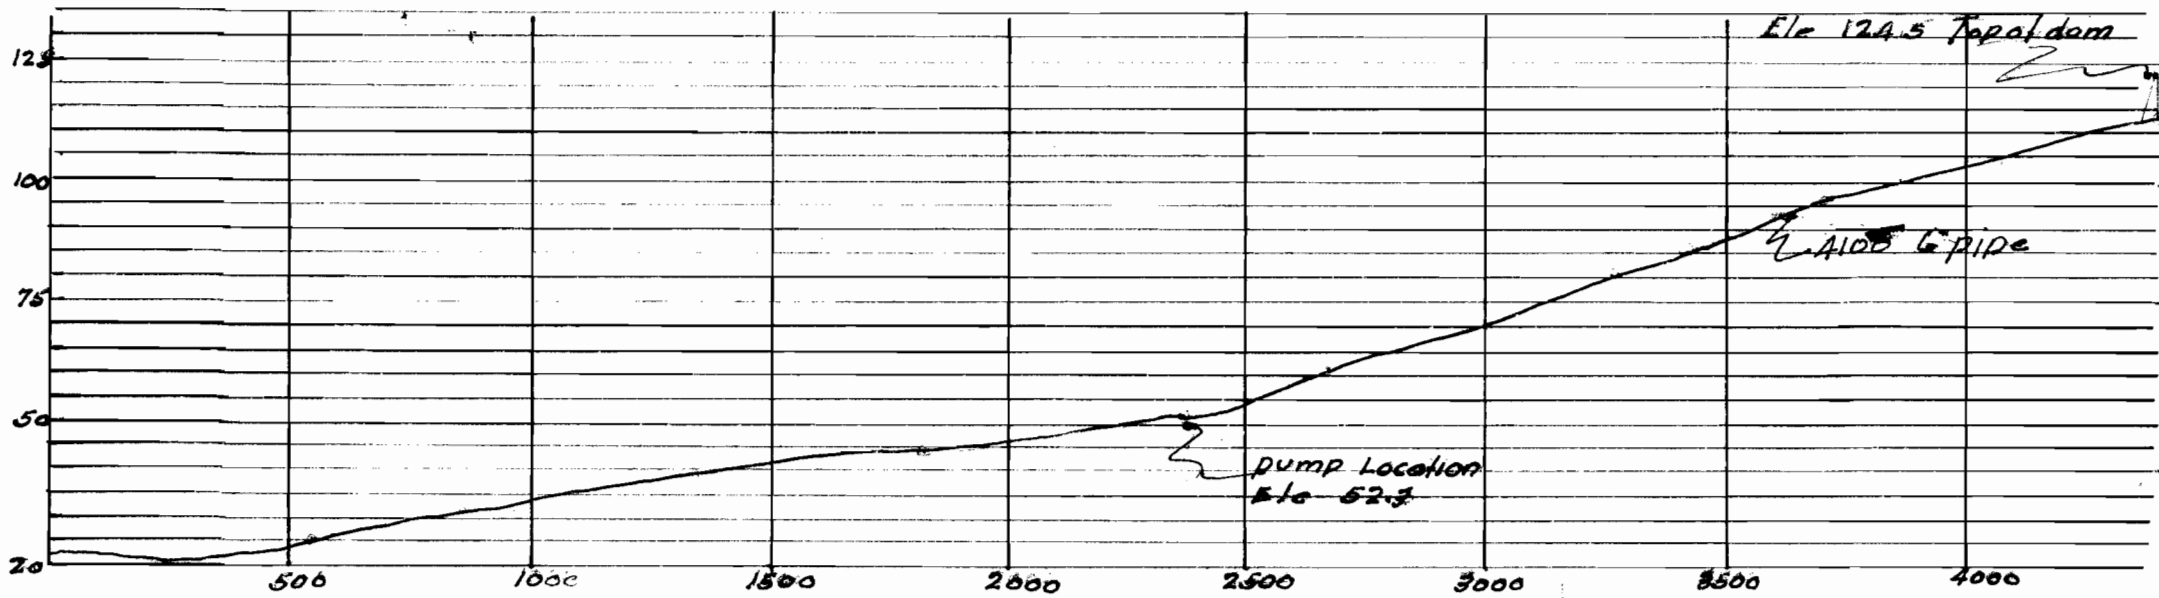


SEC 34 DAM

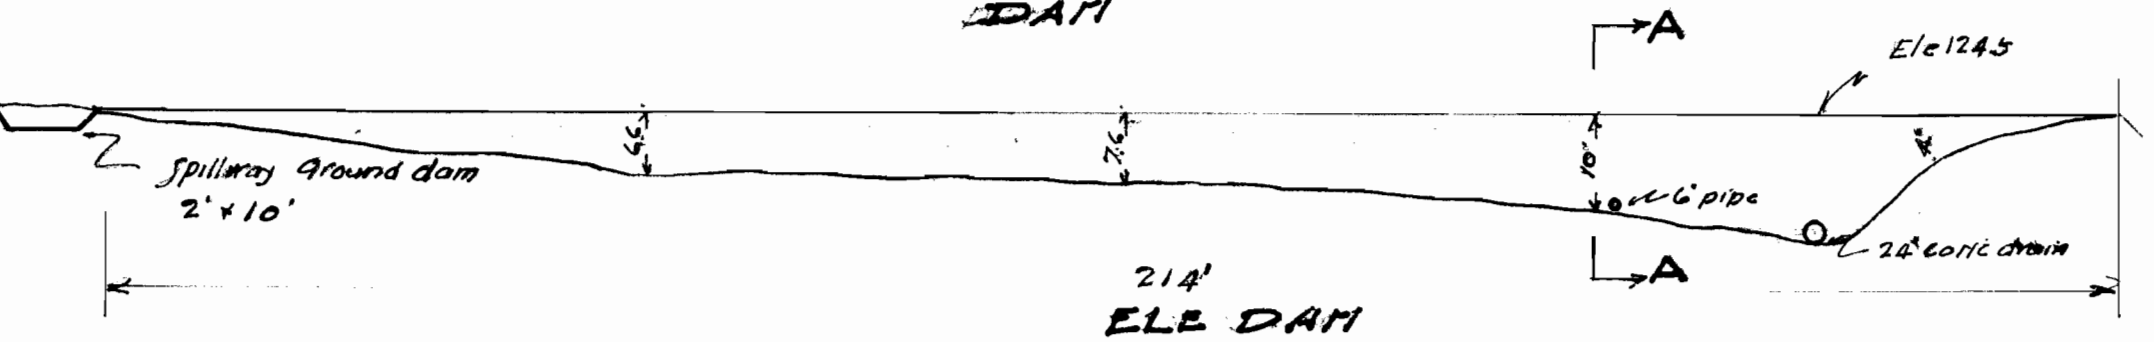

SURVEYOR'S CERTIFICATE

I, W.E. Anderson of Tillamook Ore do hereby certify that this map was made from notes taken during an actual survey made by me in Oct 1951 and that the monuments shown are with reference to the S.E. cor SW 1/4 of NW 1/4 Sec 35.

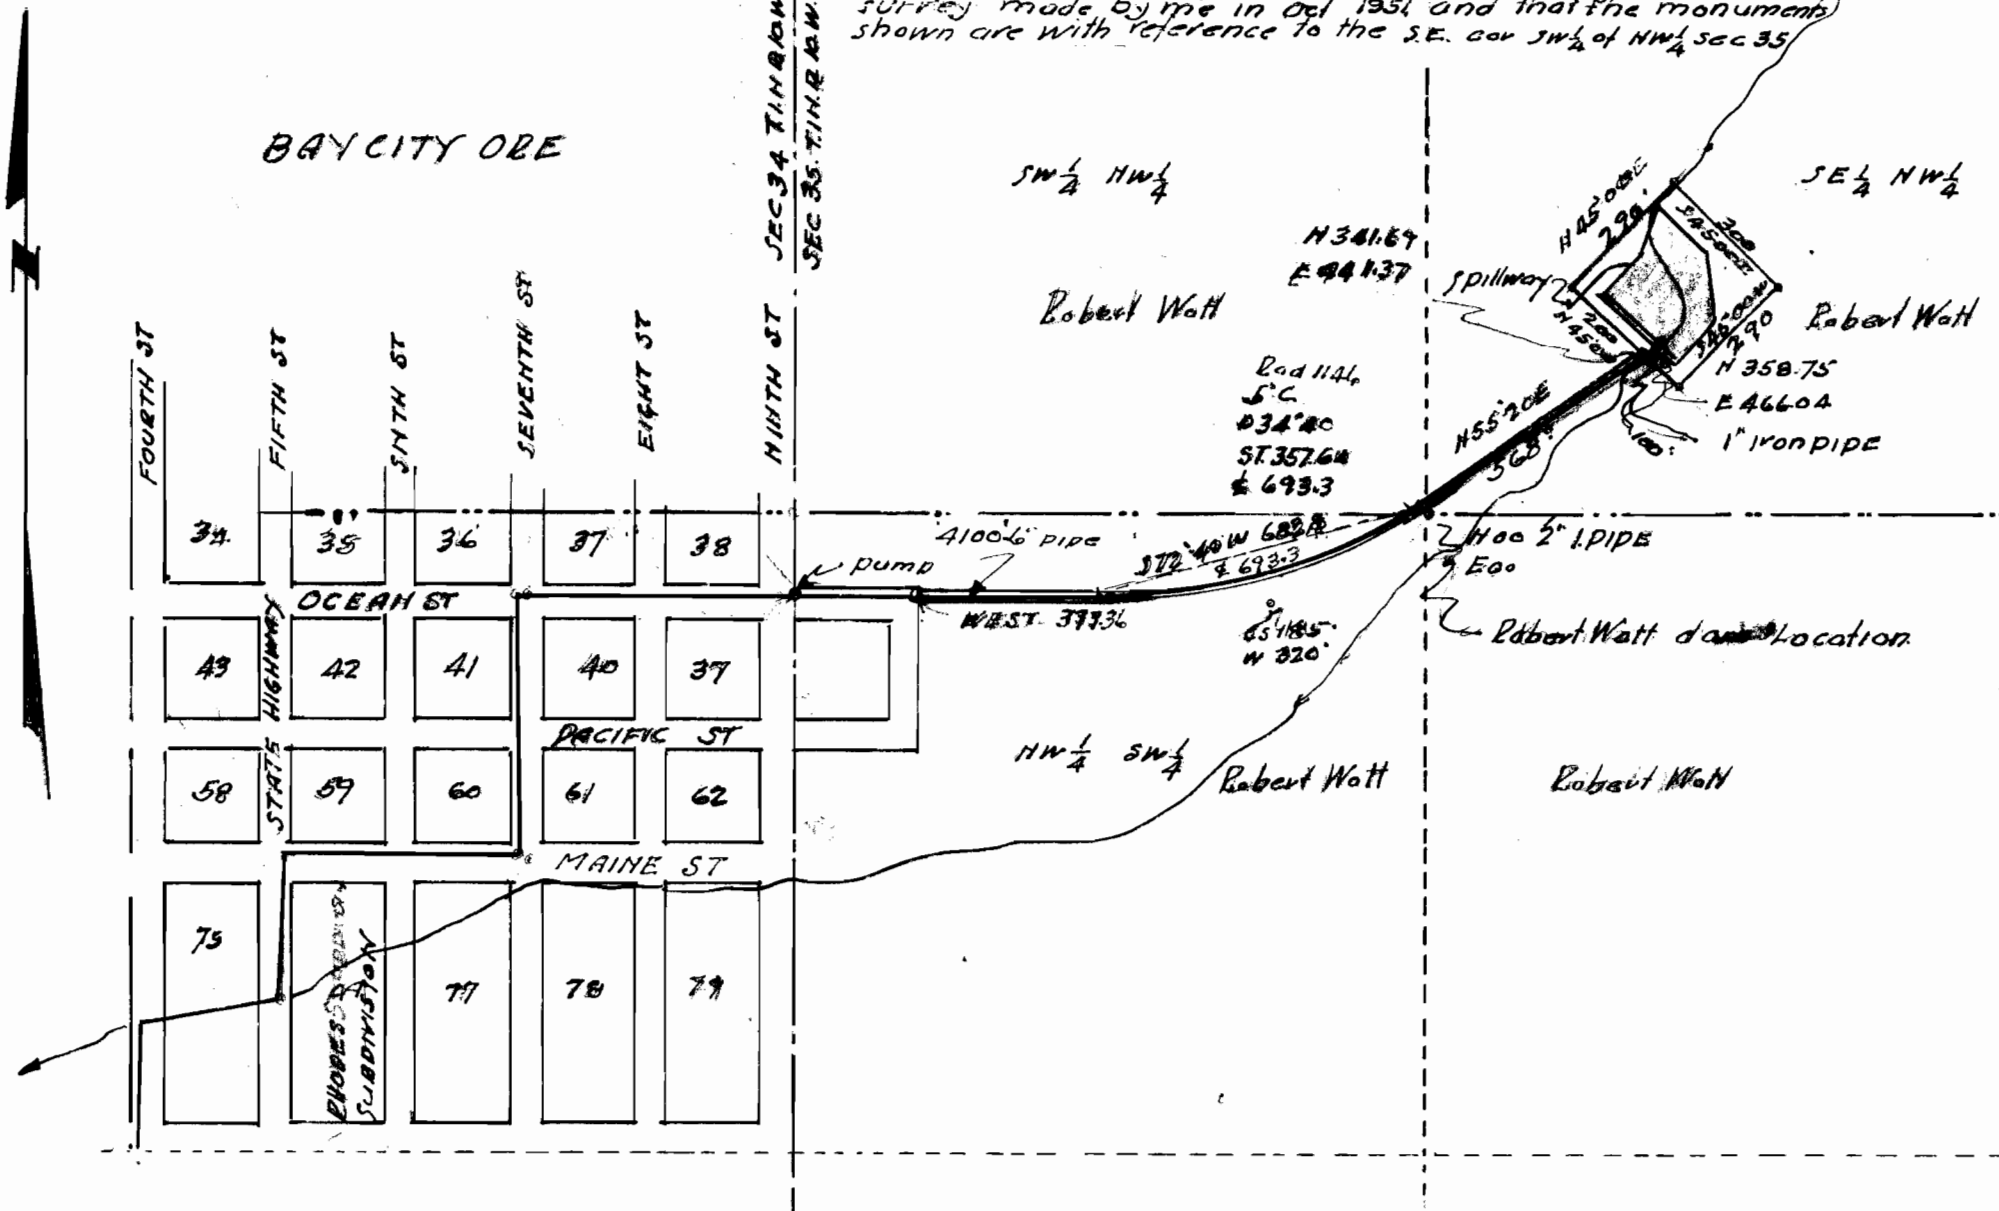

BAY CITY WATER RIGHT
LOCATED ON
PATTERSON CREEK
SEC 35 T.14N. R.10W. W.1/4
TILLAMOOK ORE
Scale 1" = 400'

Application No.
Permit No.

R-26690
26691
121287