


T.3S., R.2W. W.M.

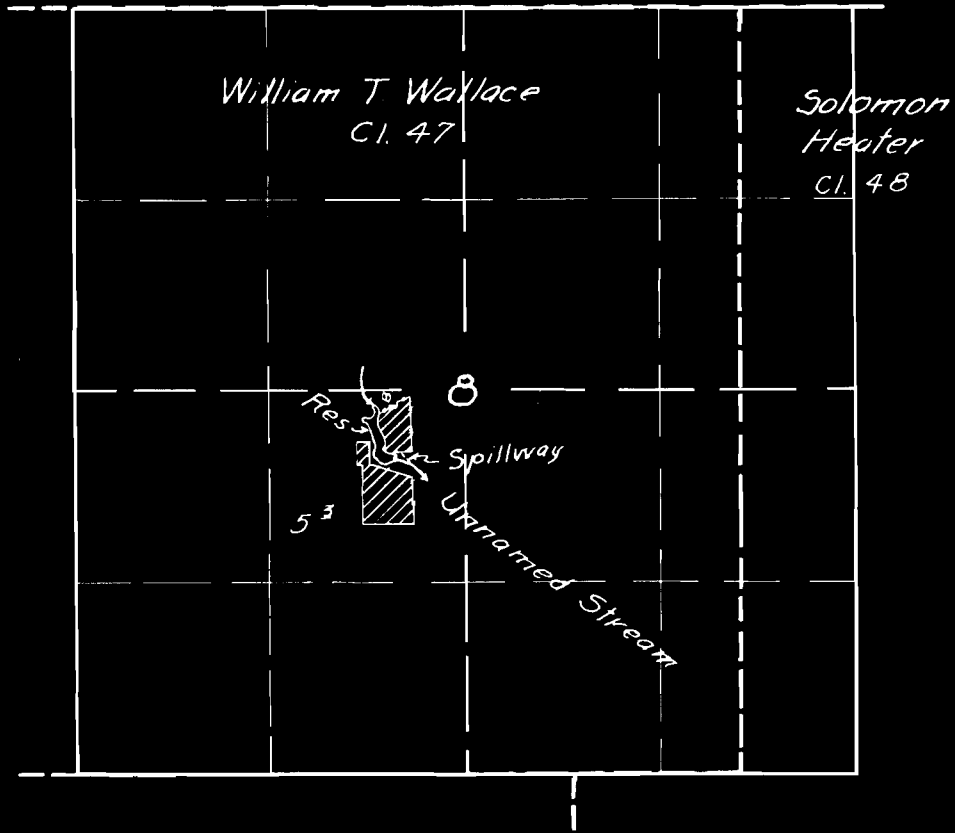

R25198
25199

R-1298
20962

F. R. BARON

23 Sept. 1955

Robert K. Reed

1955U.