


T2S R9WWM

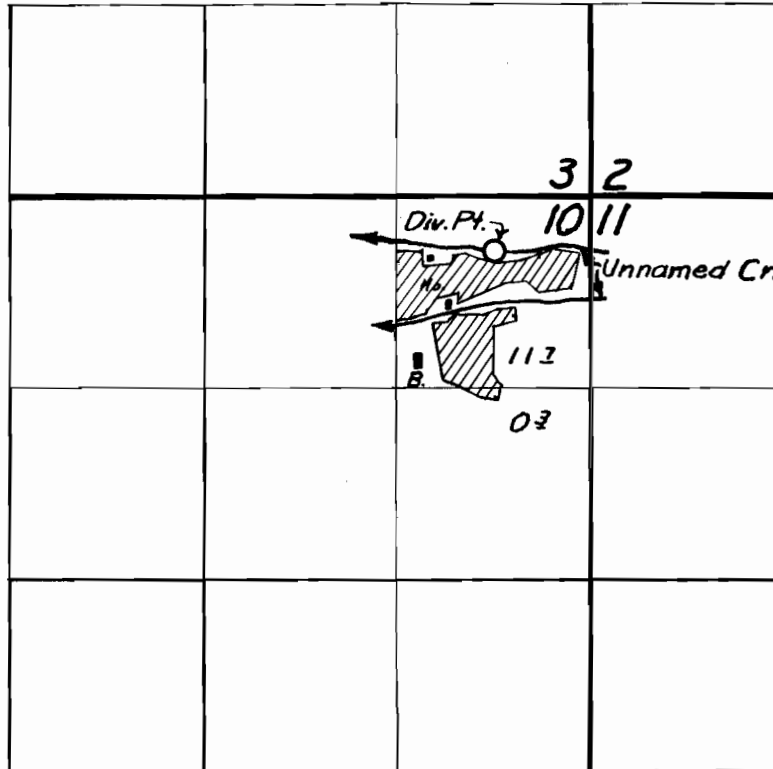

**FINAL PROOF SURVEY**

UNDER

Application No. 26286 Permit No. 20632

IN NAME OF

**ED GROSSEN & SON**

Surveyed July 28 1955, by *M. Bish*