


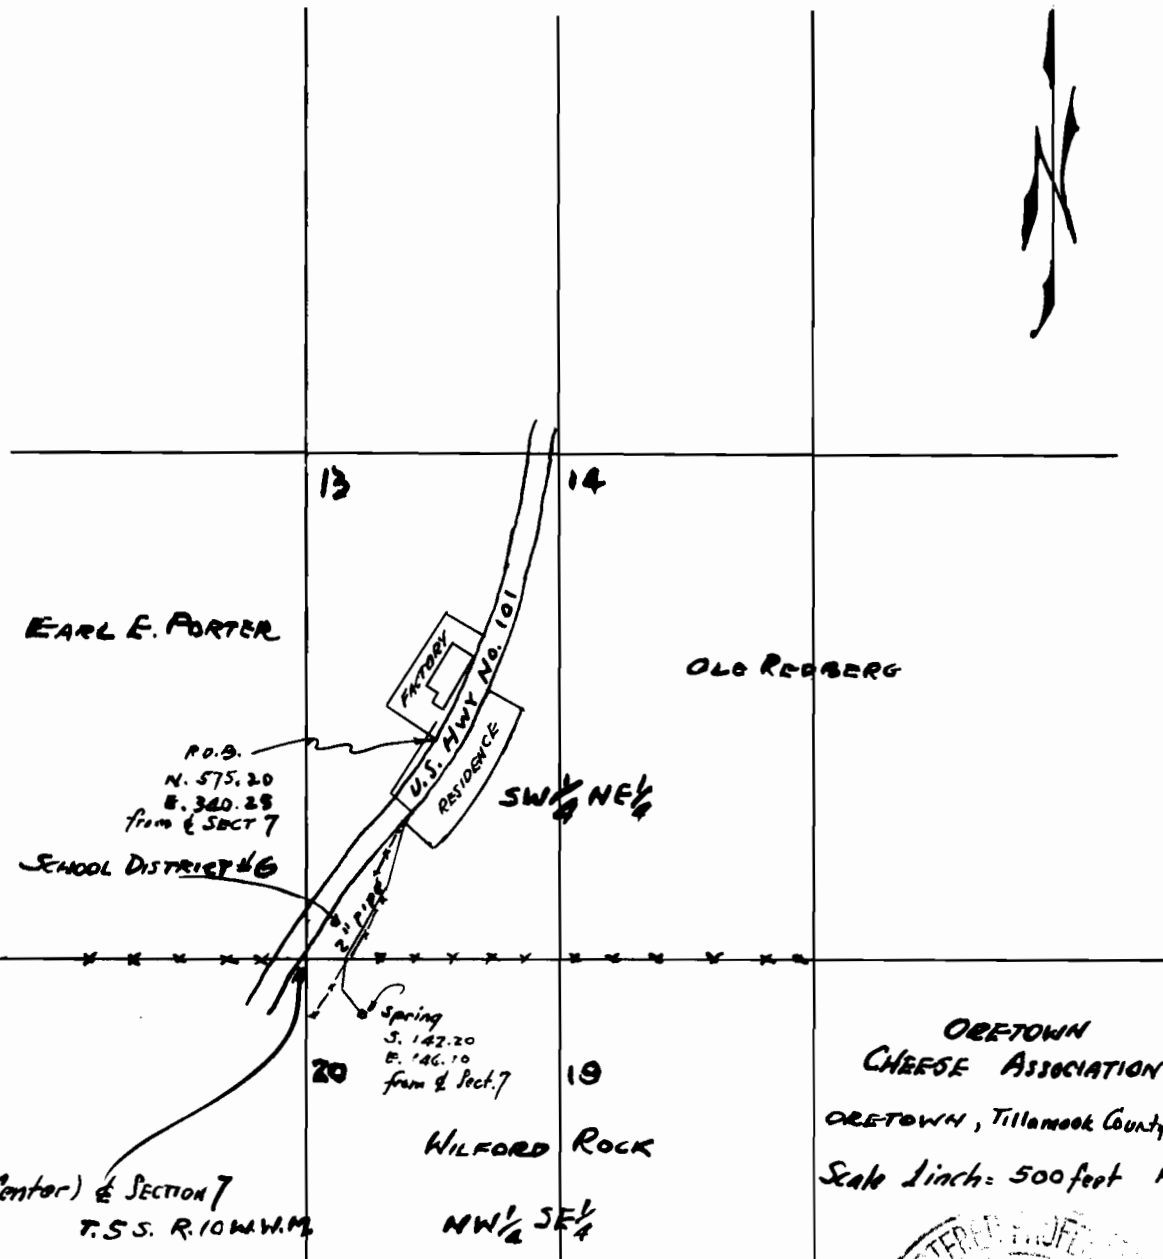

Application No. 26302
Permit No. 20645

