


T. 2 S. R. 9 W. W. M.

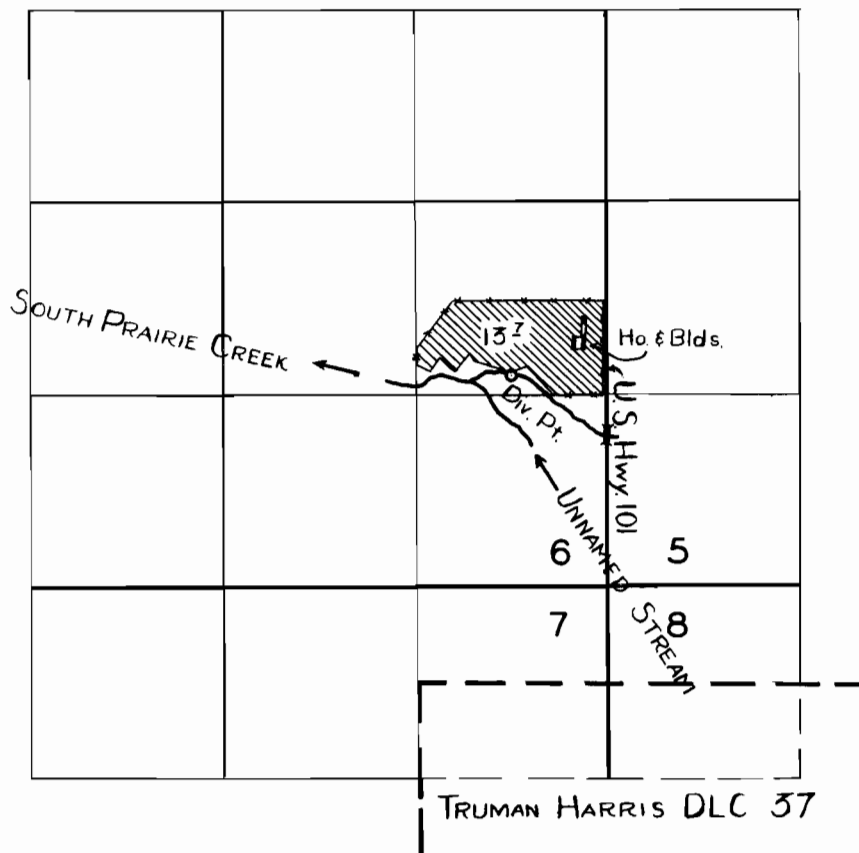

FINAL PROOF SURVEY
UNDER

Application No. 26350 Permit No. 20673
IN NAME OF

NICK C. HORRAS

Surveyed 2 Aug 1955, by