


T.1S.R.9W.W.M.

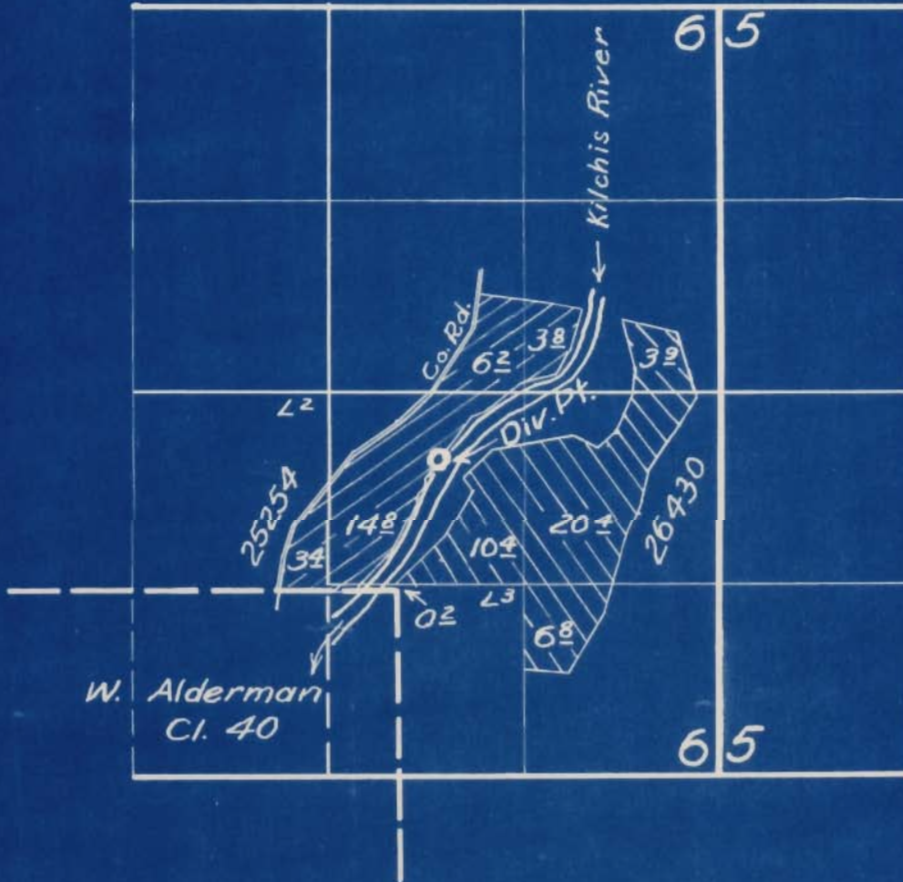

FINAL PROOF SURVEY

UNDER

25254

19839

Application No. 26430

Permit No. 20727

IN NAME OF

*Louie Landolt
Landolt Brothers*

Surveyed July 5th 1955, by *M. O. Seal*