


T2SR9WWM

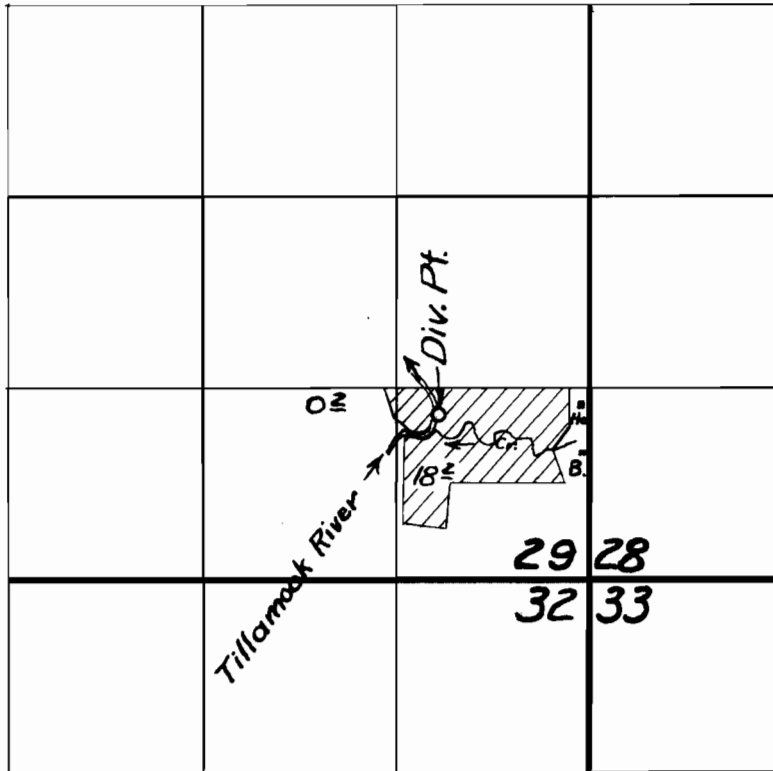

**FINAL PROOF SURVEY**

UNDER

Application No. *26493* Permit No. *20764*

IN NAME OF

***ALBERT WADE***

Surveyed *Sept. 8* 1955, by *M. Bish*

1955M