


T. 2 S. R. 9 W. W. M.

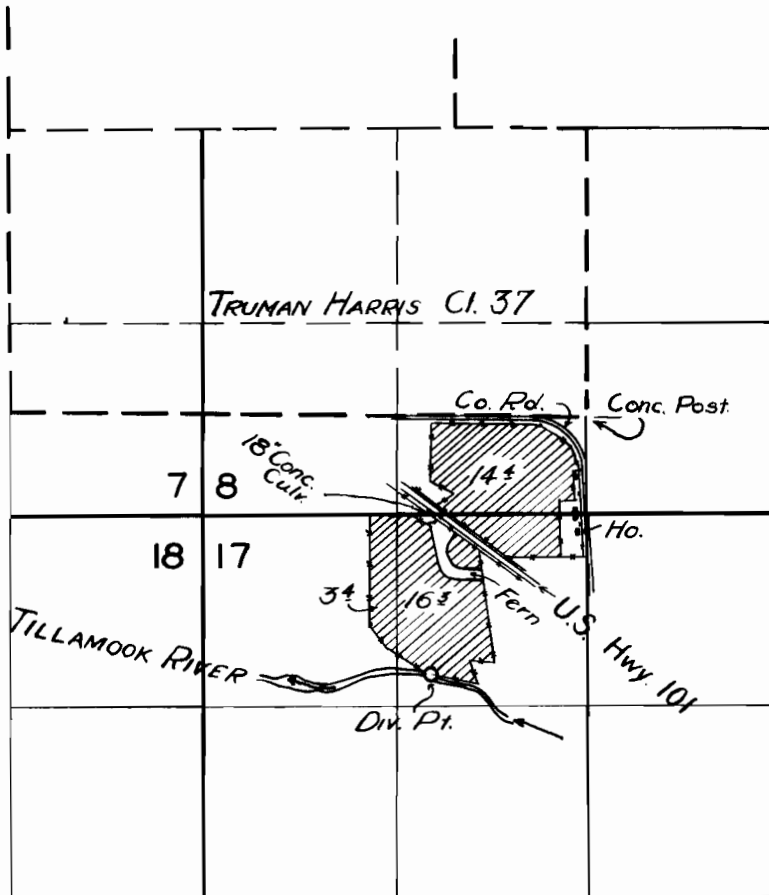

FINAL PROOF SURVEY

UNDER

Application No. 26575 . Permit No. 20822

IN NAME OF

BAPTIST BUCHLER

Surveyed 3 Aug. 1955, by *[Signature]*