


T6SR10WWM

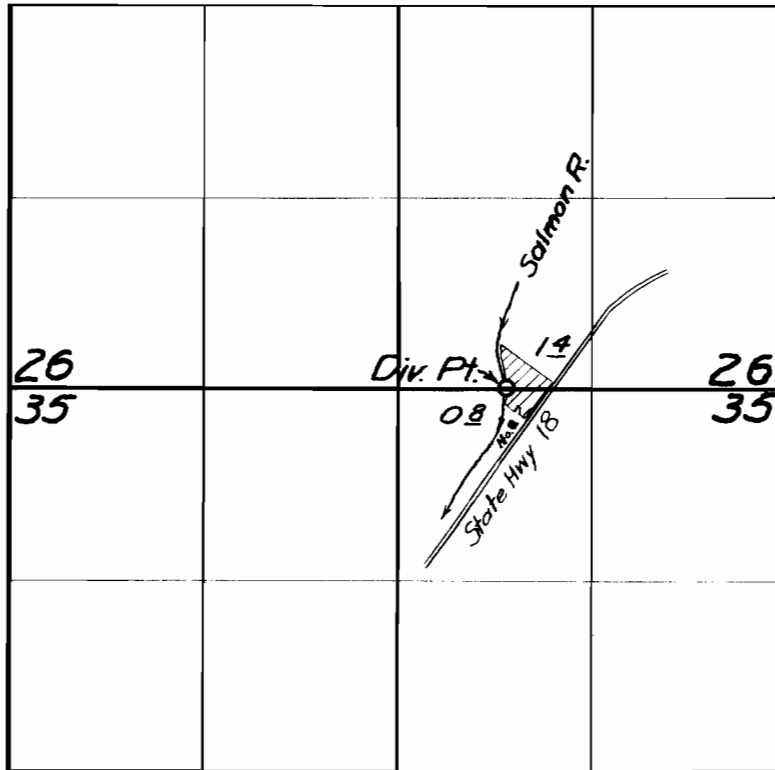

**FINAL PROOF SURVEY**

UNDER

Application No. *26853* Permit No. *21089*

IN NAME OF

*Estate of Carl L. Paul*

Surveyed *Aug 29 1955* by *m. Besh*