


T. 3 & 4 S. R. 4 W. W.M.

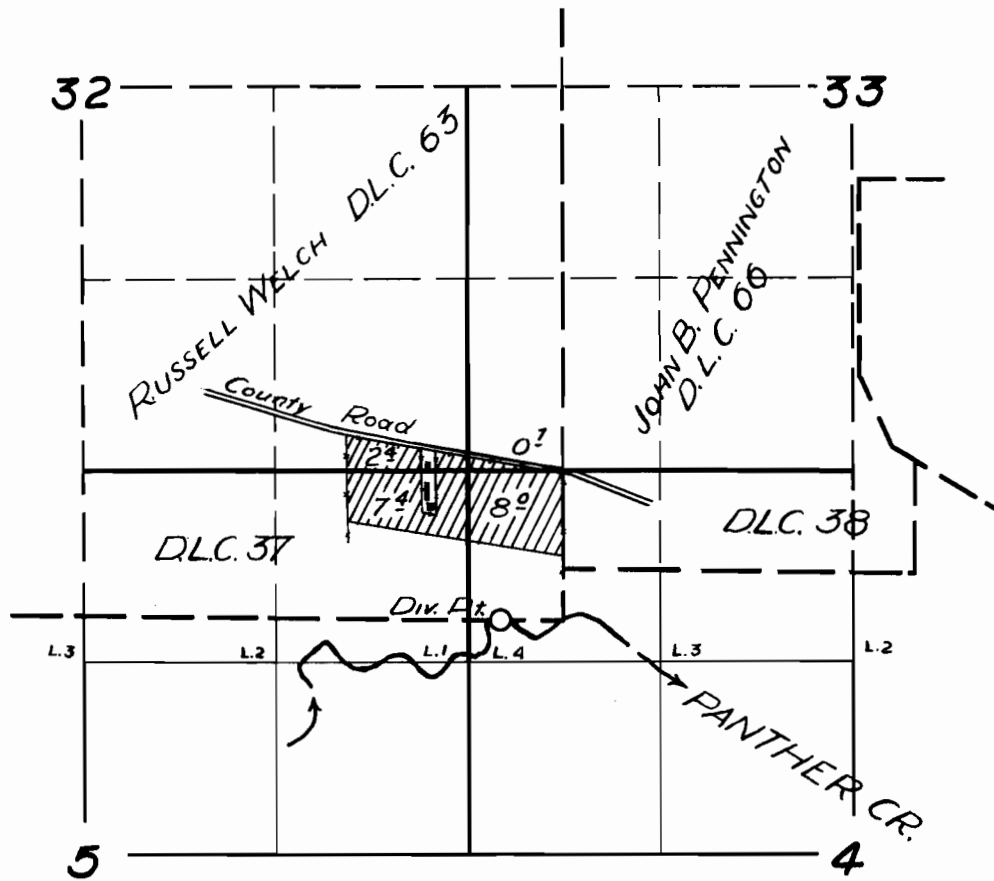

**FINAL PROOF SURVEY**  
UNDER

Application No. 27016 Permit No. 21218  
IN NAME OF

**CHARLES E. SITTON**

Surveyed 22 Sep. 1955 by *C. H. Whiteby*

DFQ-5D-60