


T.34S.R.8WWM

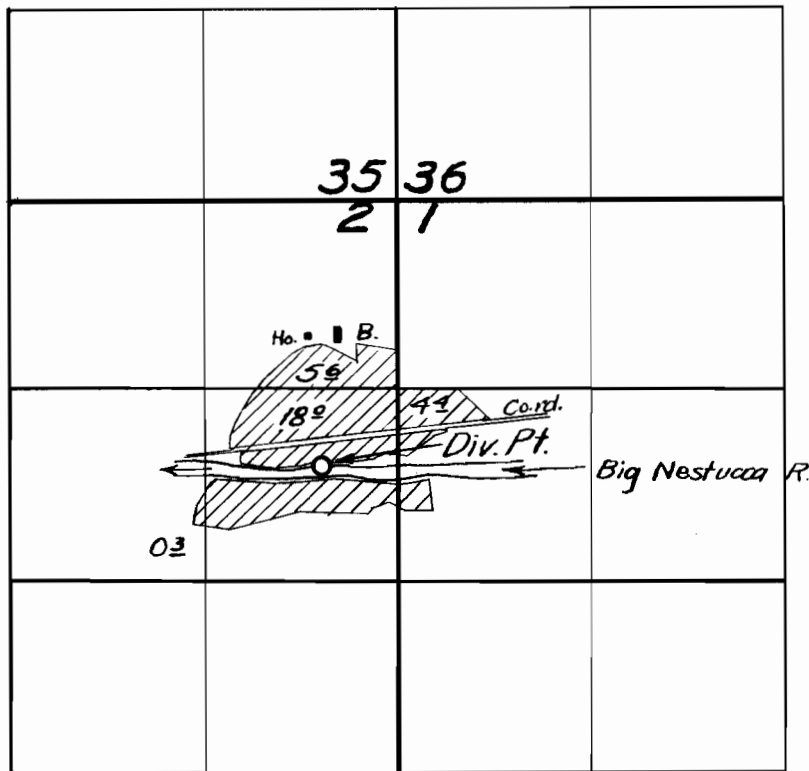

FINAL PROOF SURVEY

UNDER

Application No. 27039 Permit No. 21278

IN NAME OF

Russell S. Jones

Surveyed *Sept. 9* 1955, by *M. Bishop*