


T. 10 S., R. 9 W. W. M.

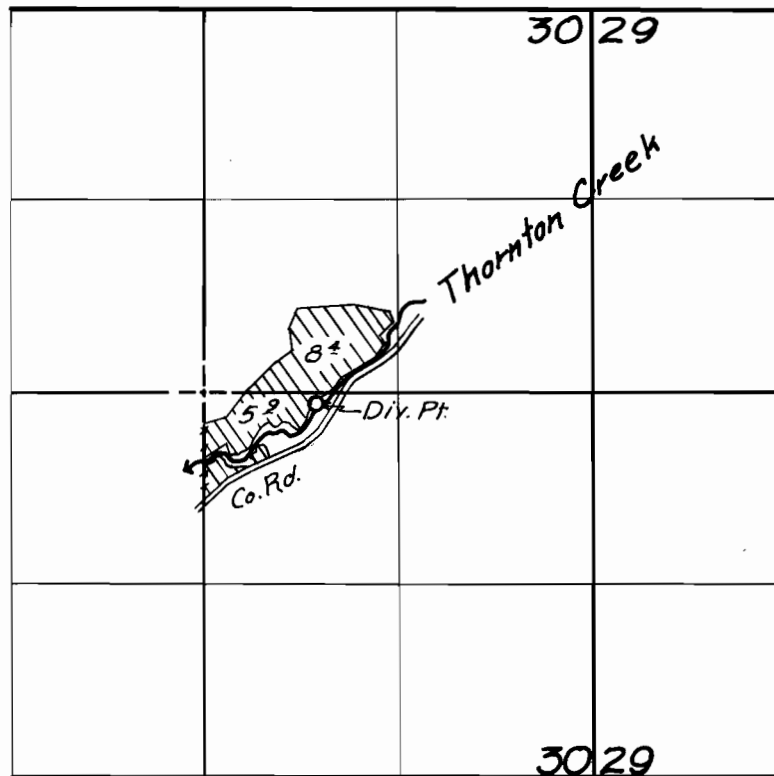

FINAL PROOF SURVEY
UNDER

Application No. 27169 Permit No. 21367
IN NAME OF

MILTON FAXON & SONS

Surveyed 21 April 1955, by H. L. Coffman