


West 1/4
Corner
Section 27
Twp 25 South
Range 12 W.W.M.

Found 1 1/2" L.P.
Brass Cap -
Z. B. T. S.

T.I.E. $572^{\circ}-39'W$
1720.5'

Lots 1 & 2 are
in the NW 1/4
Section 27

SECTION 27
SECTION 28

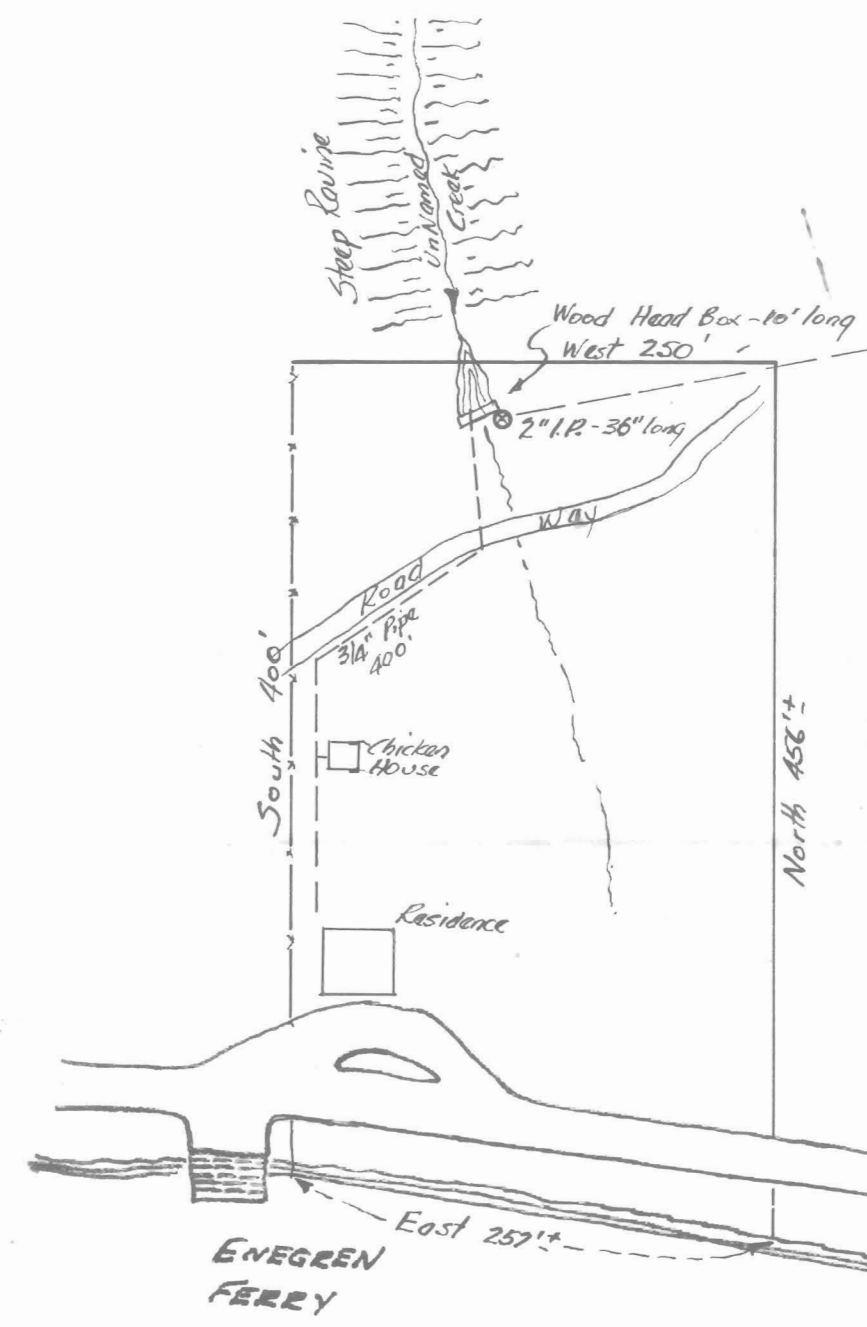

LOT 2

LOT 1

NORTH



WATER RIGHTS SURVEY
Lot 2, SECTION 27
Township 25 S, Range 12 W.W.M.
Coos County, Oregon.
1" = 60' 7-10-52

Application No. 27497
Permit No. 21493