


T.20S.R.47E.W.M.

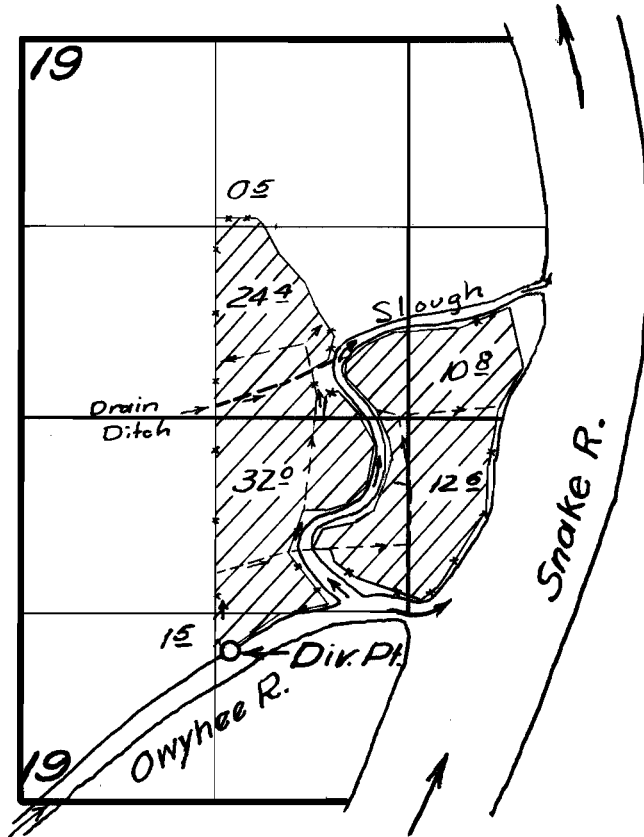

FINAL PROOF SURVEY

UNDER

Application No. 27586 Permit No. 21568

IN NAME OF

Robert L. Adams

Surveyed Oct. 14 1955, by Tr. Bish